

The City of Prince George does not represent or guarantee that the information contained in this document is accurate or reliable, and any person who relies on this information in this document does so at their own risk.

City of Prince George  
This information has been provided subject to the Federal Copyright Act and in accordance with the Provincial Freedom of Information and Protection of Privacy Act.

THE SEAL AND SIGNATURE OF THE UNDERSIGNED ON THIS DRAWING CERTIFIES THAT THE DESIGN INFORMATION CONTAINED IN THESE DRAWINGS ACCURATELY REFLECTS THE ORIGINAL DESIGN AND THE MATERIAL DESIGN CHANGES MADE DURING CONSTRUCTION, THAT WERE BROUGHT TO THE UNDERSIGNED'S ATTENTION. THESE DRAWINGS ARE INTENDED TO INCORPORATE ADDENDA, CHANGE ORDERS AND OTHER MATERIAL DESIGN CHANGES, BUT NOT NECESSARILY ALL SITE INSTRUCTIONS. THE UNDERSIGNED DOES NOT WARRANT OR GUARANTEE, NOR ACCEPT ANY RESPONSIBILITY FOR THE ACCURACY OR COMPLETENESS OF THE AS-CONSTRUCTED INFORMATION SUPPLIED BY OTHERS CONTAINED IN THESE DRAWINGS, BUT DOES, BY SEALING AND SIGNING, CERTIFY THAT THE AS-CONSTRUCTED INFORMATION, IF ACCURATE AND COMPLETE, PROVIDES AN AS-CONSTRUCTED SYSTEM WHICH SUBSTANTIALLY COMPLIES IN ALL MATERIAL RESPECTS WITH THE ORIGINAL DESIGN INTENT.


RECORD DRAWING

station one architects

Abbotsford 203-2190 W. Railway St V2S 2E2

Chilliwack 9355 Young Rd V2P 4S3

604 793 9445

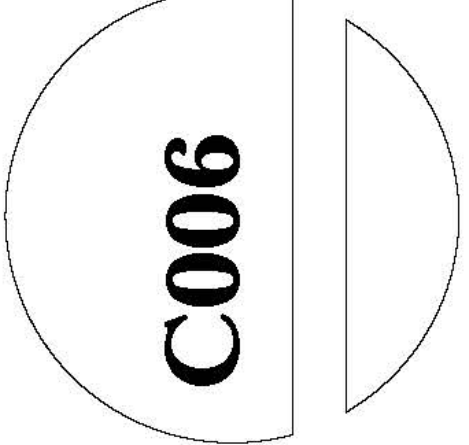

DRAWING NAME	
PROPOSED GRADING PLAN	
JOB NO.	1759-01
SCALE	1:50
DATE	September 6 2021

REVISIONS	
NO.	DESCRIPTION
1	OCT. 13 2021 ISSUED FOR 90% DESIGN
2	OCT. 29 2021 ISSUED FOR BUILDING PERMIT
3	JAN. 14 2022 ISSUED FOR TENDER
4	APR. 21 2022 ISSUED FOR CONSTRUCTION
5	JUN. 15 2022 CCN 2 - RELOCATED CBMH 1
6	NOV. 7 2022 REVISED PARKING LOT GRADING
7	JUN. 8 2023 REVISED PARKING LOT GRADING
7	NOV. 30 2023 RECORD DRAWING

BRIARWOOD APARTMENTS  
PHASE 1  
1330 & 1380 FOOTHILLS BOULEVARD,  
PRINCE GEORGE, BC

**ENGINEERING LIMITED**  
1210 FOURTH AVENUE  
PRINCE GEORGE, B.C.  
V2L 3J4  
TEL (250) 562-1977  
FAX (250) 562-1987  
EGBC PERMIT TO PRACTICE No. 1002375

PROFESSIONAL OF  
T.A. FJELLSTROM  
# 20194  
BRITISH COLUMBIA  
ENGINEER  
PERMIT TO PRACTICE  
NO 1002375  
2023-12-01

soarchitects.com