

REFERENCE DRAWINGS		

MBE = MINIMUM BASEMENT ELEVATION

• 100.00 PROPOSED LOT CORNER ELEVATION

AS CONSTRUCTED INFORMATION REVIEWED AND APPROVED BY TOWER ENGINEERING.

*Blair Blair*  
Mar. 5/99.


NO.	DATE	DESCRIPTION	BY	APP.
2	02/98	AS-CONSTRUCTED, UNDERGROUND	EL	
1	01/98	CITY REVIEW SUBMISSION	EL	

REVISIONS & ISSUES	
DESIGN	EL
DRAWN	EL
CHECKED	BT
P. ENG. SEAL	

APP'D BY CONSULTANT DATE 01/09/98

APP'D BY CITY DATE

SCALE  
HORIZ. 1:750  
VERT. -

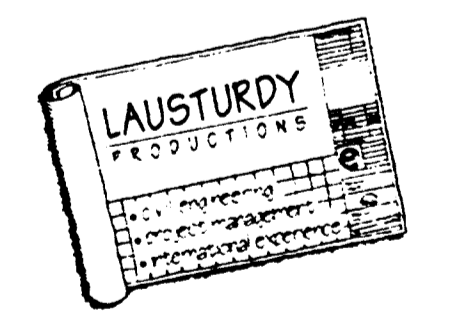

ABERDEEN GLEN DEVELOPMENT  
487968 B.C. LTD.

ABERDEEN GLEN SUBDIVISION  
PHASE I  
BLOCK A  
DISTRICT LOT 4377  
CARIBOO DISTRICT  
MCTAVISH ROAD  
LOT GRADING

SHEET 4 OF 9

CONSULTANT DWG. No. 98-02-204

CITY DWG. No. E4689-4 REV. 2