


79H8445
 N: 5973371.028
 E: 516267.087
 EL: 582.332

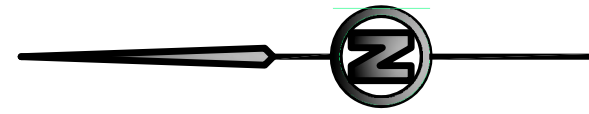

VOLUME TABLE			
MATERIAL	CUT (m ³)	FILL (m ³)	NET (m ³)
EARTHWORKS	3,260	2,680	580 CUT
SELECT GRANULAR SUBBASE	-	1,700	1,700 FILL
WELL GRADED BASE	-	500	500 FILL
TOP SOIL	-	1,590	1,590 FILL

- DRAWING NOTES**
- SEE DRAWING C-001 FOR GENERAL NOTES.
 - ALL WORK TO BE CARRIED OUT IN ACCORDANCE WITH THE PLATINUM EDITION OF THE MMCD 2009 AND THE CITY OF PRINCE GEORGE SUBDIVISION CONTROL BYLAW 7652.
 - TRAILS TO BE INSTALLED AS PER SECTIONS ON DRAWING C-501.

LEGEND

BENCHMARK		BM
IRON PIN		IP
BOLLARD - E & P		
PROPERTY LINE		
EASEMENT		
FENCE - E		
FENCE - P		
TRAIL C - P		
PAVEMENT EDGE - P		
CUT/FILL DAYLIGHT		
DITCH - P		

REFERENCE DRAWINGS

DWG No.	REV	PROJECT No.	PRODUCED BY

DRAWING REVISIONS

REV	DATE	DRW	DES	APP	REVISION
2	22.12.22	KN	KN	KN	RECORD DRAWING

PRIME CONSULTANT





Scouten ENGINEERING
 201 - 1968 QUEENSWAY
 PRINCE GEORGE • BC • V2L 1M2
 info@scoutenengineering.com
 T 250.562.7050



CITY OF PRINCE GEORGE
RON BRENT PARK CONCEPTUAL DEVELOPMENT
PROPOSED GRADING PLAN

PROJECT No.	DRAWING No.	REV
1368-01	C-102	2

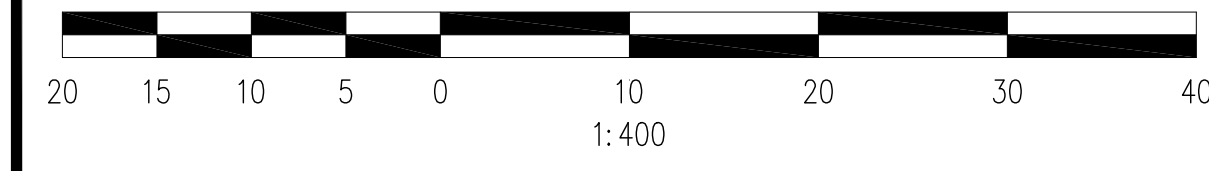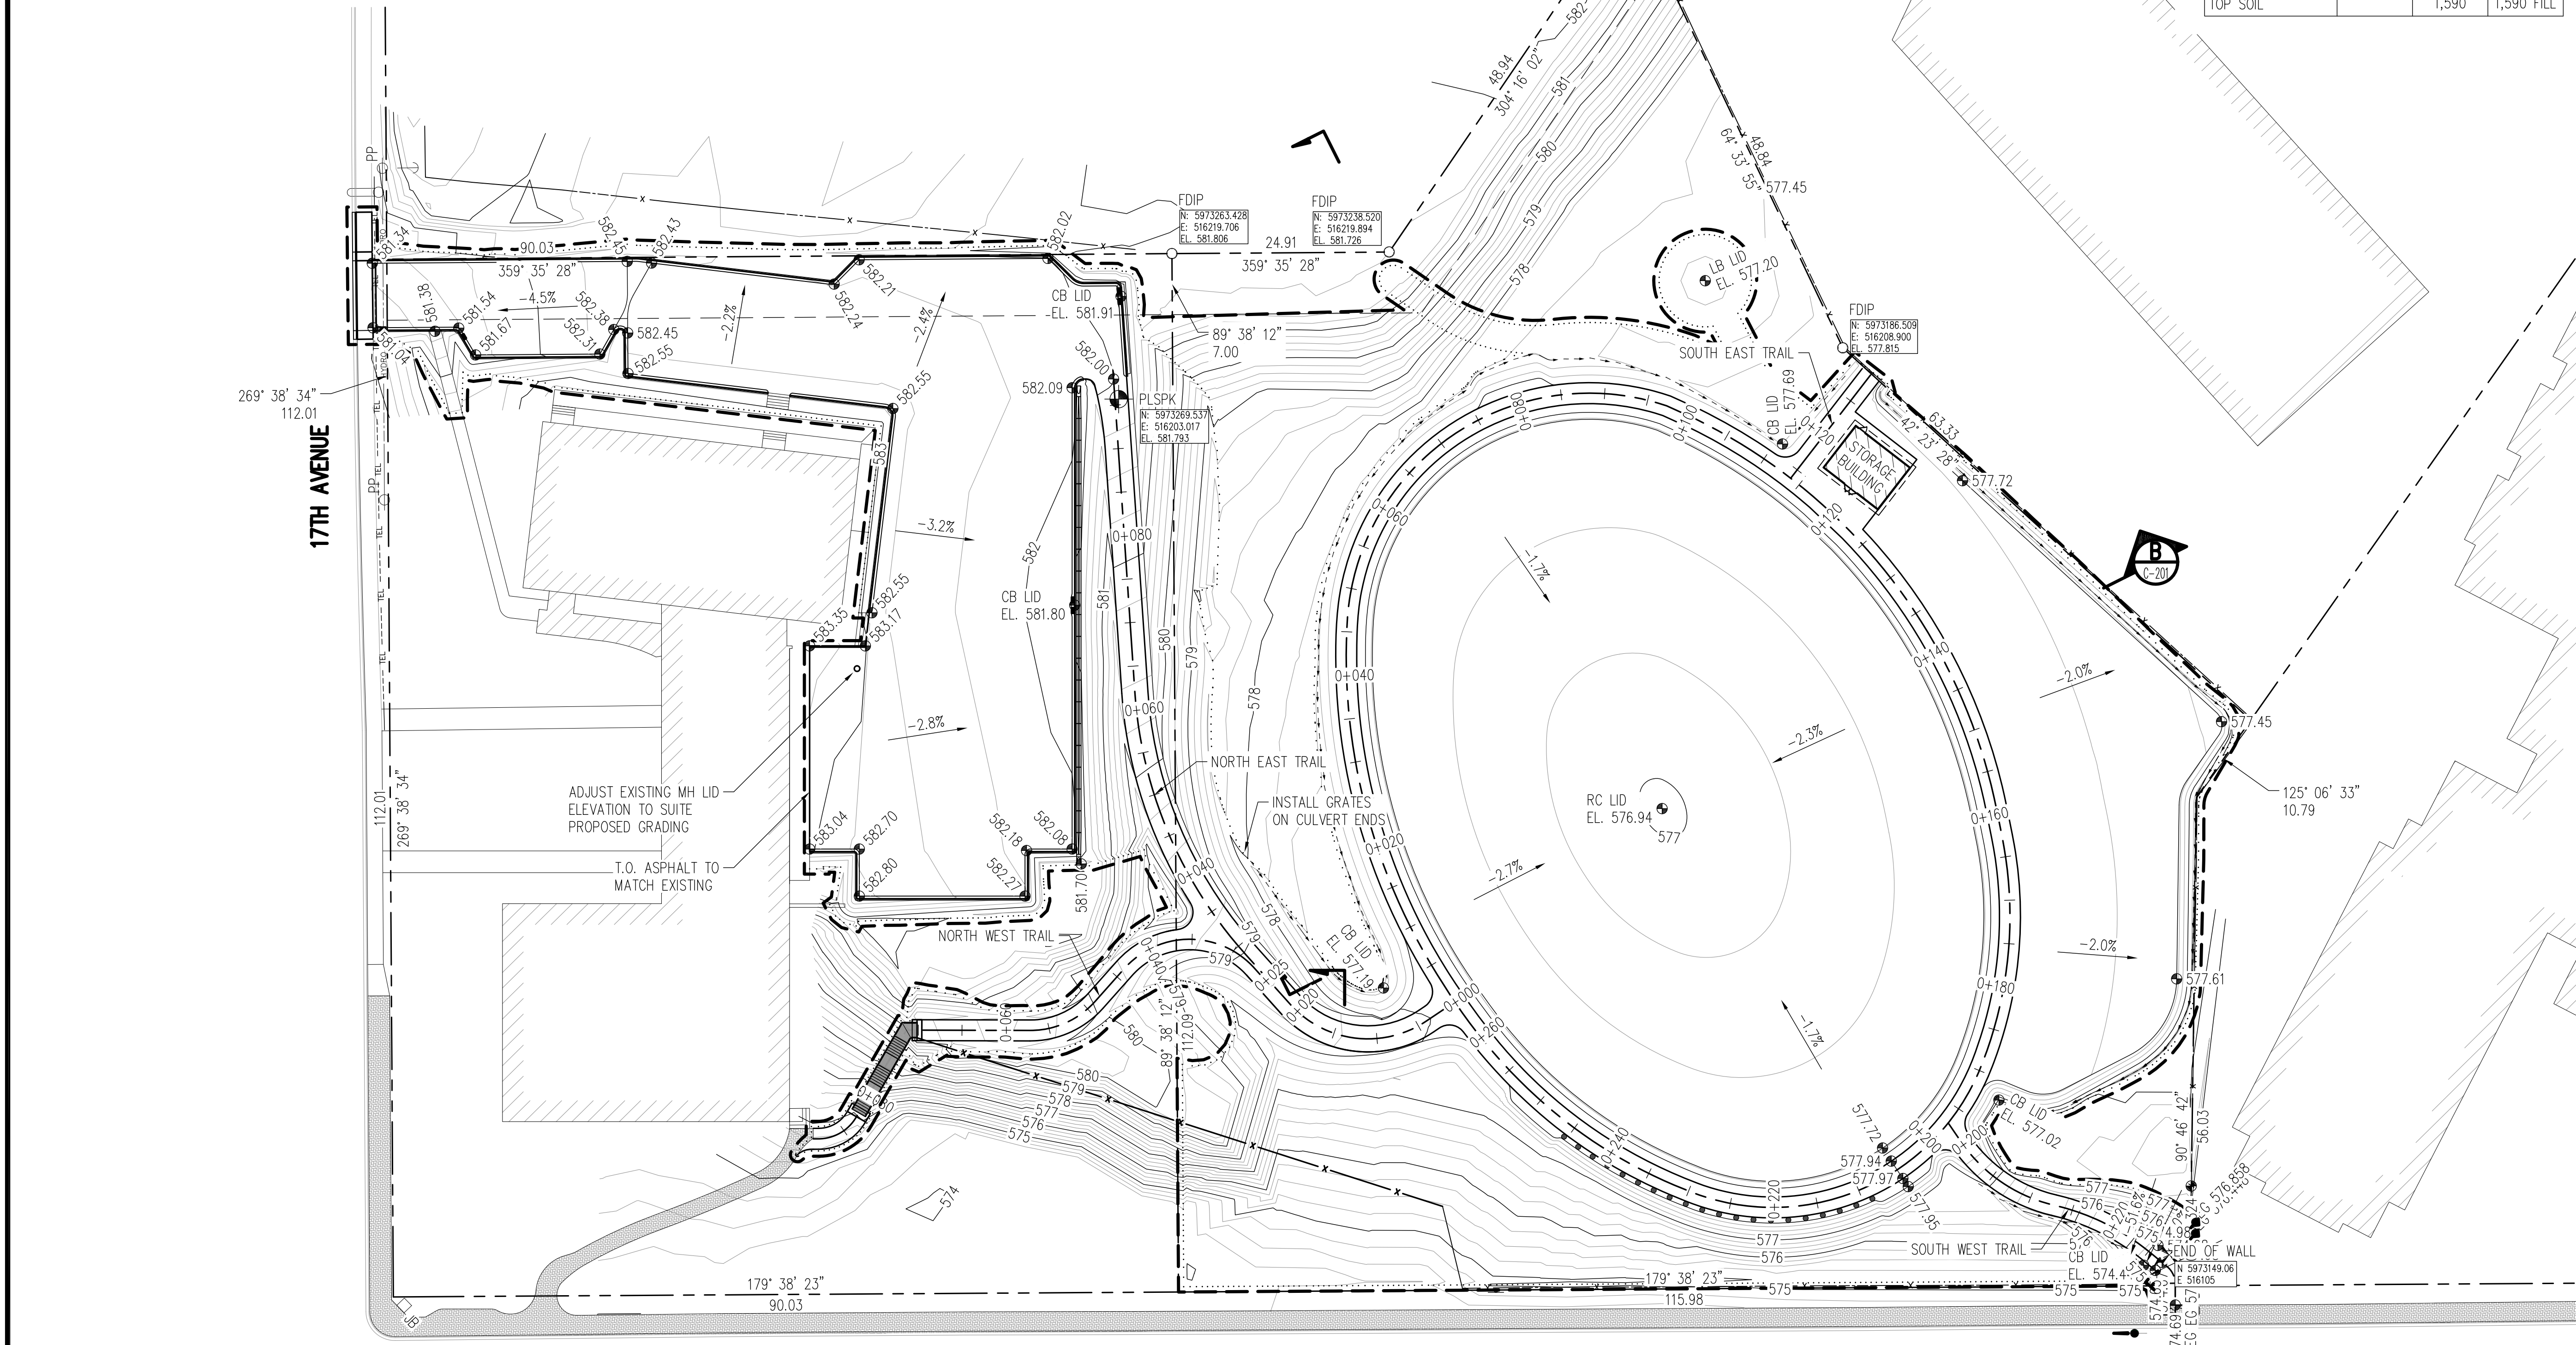

PLMAG-167
 N: 5973154.028
 E: 516073.765
 EL: 574.540

RECORD DRAWINGS

FILE NAME: 1368-01 [C] Prop Grading.dwg LAST UPDATED: 22.12.22 DISCARD ALL PREVIOUS REVISIONS