

TYPICAL LOT GRADING SPLIT SURFACE DRAINAGE

LEGEND

EXISTING

- EX. TEST PIT & DRILL HOLE
- EX. BENCHMARK & SURVEY HUBS
- EX. I.P.s & ISM's
- EX. LEGAL LINE
- EX. LEGAL R.O.W. & EASEMENT
- EX. SANITARY & MANHOLE
- EX. SANITARY FORCE MAIN
- EX. STORM & MANHOLE
- EX. SINGLE & DOUBLE CATCHBASIN c/w CB LEADS
- EX. CATCHBASIN MANHOLE
- EX. CULVERT
- EX. FIRE HYDRANT & VALVE ASSEMBLY
- EX. WATERMAIN & VALVE
- EX. BLOW-OFF ASSEMBLY
- EX. CURB STOP
- EX. ROAD & SIDEWALK
- EX. ROAD SIGN(s)
- EX. SHOULDER
- EX. TOP OF SLOPE
- EX. TOE OF SLOPE
- EX. DITCH or SWALE
- EX. FENCE
- EX. OVERHEAD LINES
- EX. UNDERGROUND LINES
- EX. POWER POLE & ANCHOR
- EX. GAS MAIN

PROPOSED

- PR. LEGAL LINE
- PR. LEGAL R.O.W. & EASEMENT
- PR. SANITARY & MANHOLE
- PR. STORM & MANHOLE
- PR. SINGLE & DOUBLE CATCHBASIN c/w CB LEADS
- PR. CATCHBASIN MANHOLE
- PR. CULVERT
- PR. DITCH or SWALE
- PR. FIRE HYDRANT & VALVE ASSEMBLY
- PR. WATERMAIN & VALVE
- PR. GRAVEL SHOULDER
- PR. ASPHALT
- PR. CURB & SIDEWALK
- PR. ROAD SIGN(s)

NO.	DATE (D/M/Y)	REVISION	BY
3	02/07/21	ADDED SWALE	DCM
2	3/06/21	RECORD DRAWING	MM
1	26/5/21	ISSUED FOR REVIEW	MM

RECORD DRAWING

CONSULTANTS PROJECT No.: 1751-01

DRAWN: JET	
CHECKED: TF	
ENGINEER: TAF	
DATE: 29/04/2021	
SCALES: HORZ. N/A	
SCALES: VERT. N/A	

MURRAY GABLE

2728 MOYIE STREET

TYPICAL LOT GRADING
SPLIT SURFACE DRAINAGE

DRAWING No.

C002

G:\Jobs Files\1700\1751 - Murray Gable Moyie Street\01 - 2728 Moyie Street\3202-1751-01_BSE_June_21.dwg



Photo No. 1



Photo No. 2

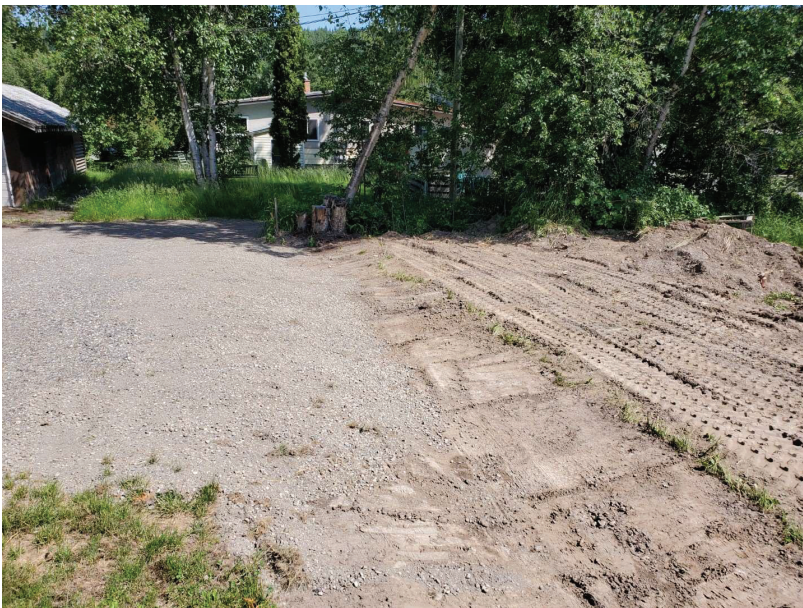


Photo No. 3