


The City of Prince George does not represent or guarantee that the information contained in this document is accurate or reliable, and any person who relies on this information in this document does so at their own risk.

City of Prince George  
 This information has been provided subject to the Federal Copyright Act and in accordance with the Provincial Freedom of Information and Protection of Privacy Act.

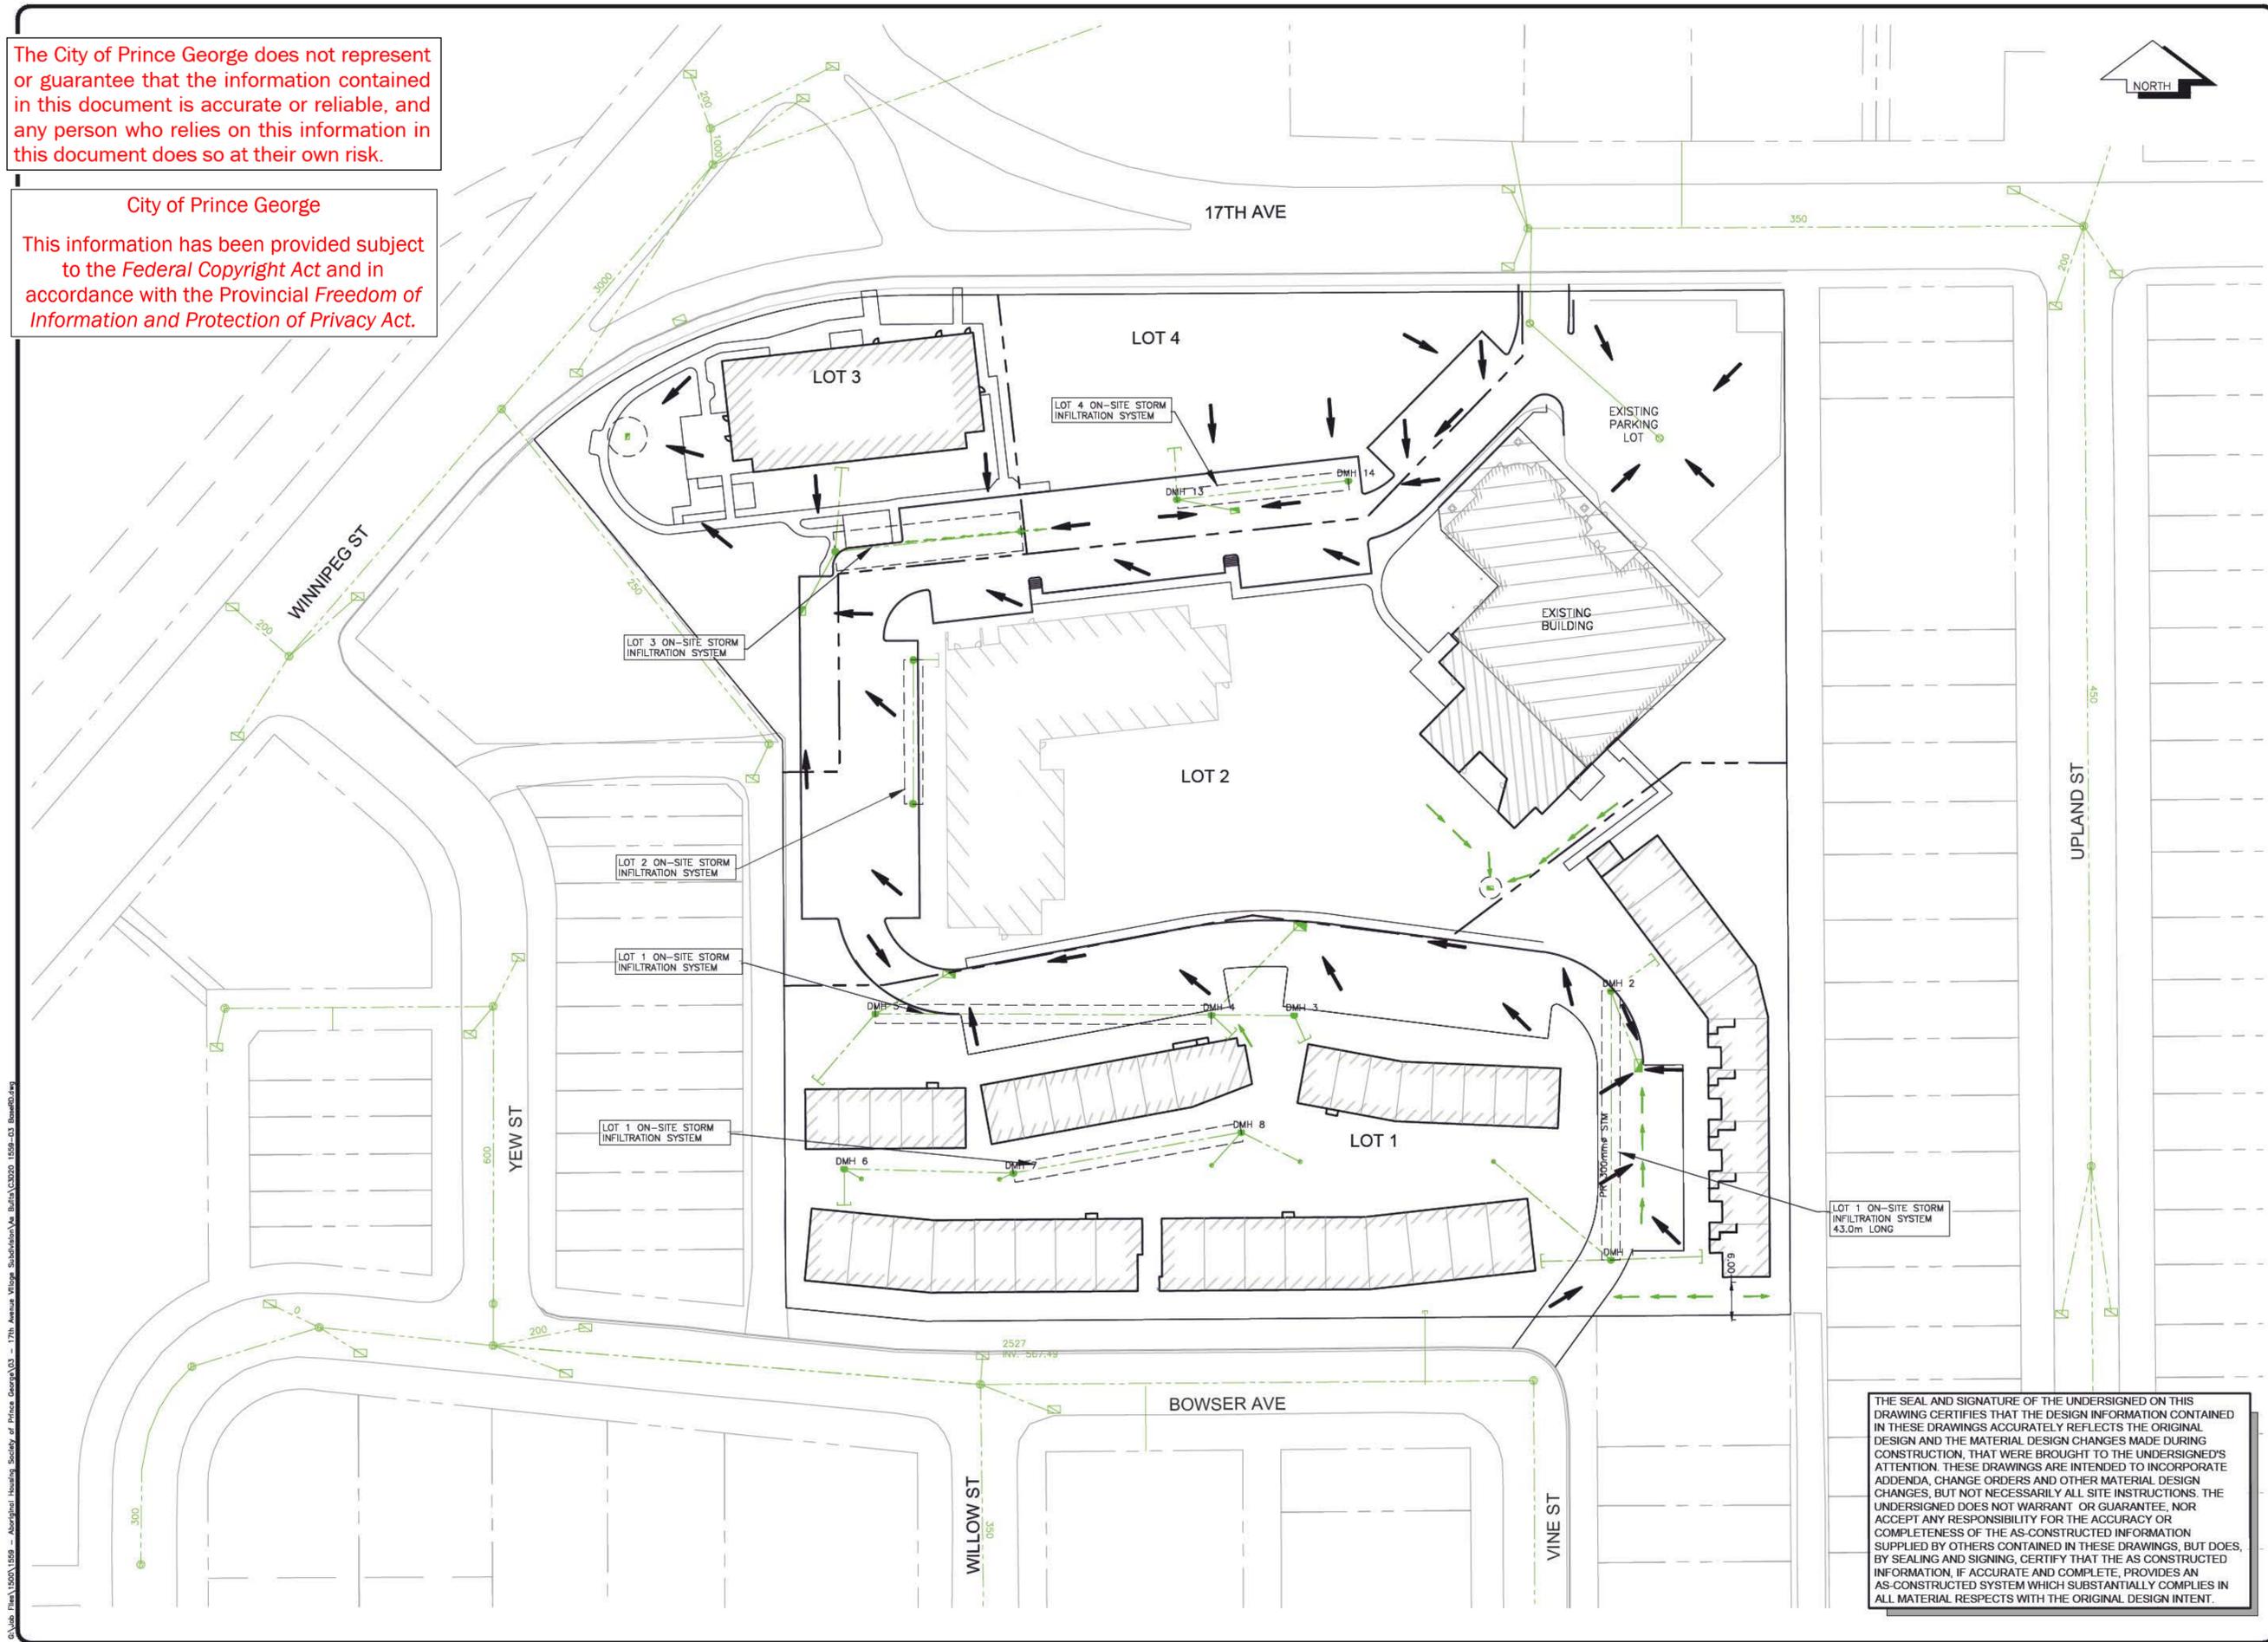

**LEGEND**

**EXISTING**

- EX. IP's & ISM's
- EX. LEGAL LINE
- EX. LEGAL R.O.W. & EASEMENT
- EX. SANITARY & MANHOLE
- EX. SANITARY FORCE MAIN
- EX. STORM & MANHOLE
- EX. SINGLE & DOUBLE CATCHBASIN w/ CB LEADS
- EX. CATCHBASIN MANHOLE
- EX. FIRE HYDRANT & VALVE ASSEMBLY
- EX. WATERMAIN & VALVE
- EX. BLOW-OFF ASSEMBLY
- EX. CURB STOP
- EX. ROAD & SIDEWALK
- EX. ROAD SIGN(s)
- EX. SHOULDER
- EX. TOP OF SLOPE
- EX. TOE OF SLOPE
- EX. DITCH or SWALE
- EX. FENCE
- EX. OVERHEAD LINES
- EX. UNDERGROUND LINES
- EX. POWER POLE & ANCHOR
- EX. GAS MAIN

**PROPOSED**

- SM
- PR. SANITARY & MANHOLE
- PR. STORM & MANHOLE
- PR. SINGLE & DOUBLE CATCHBASIN w/ CB LEADS
- PR. CATCHBASIN MANHOLE
- PR. FIRE HYDRANT & VALVE ASSEMBLY
- PR. WATERMAIN & VALVE
- PR. GRAVEL SHOULDER
- PR. ASPHALT
- PR. CURB & SIDEWALK
- PR. ROAD SIGN(s)

NO.	DATE (D/M/Y)	REVISION	BY
1	25/1/23	RECORD DRAWING	KP
0	15/9/21	ISSUED FOR SUBDIVISION	KP

RECORD DRAWING



CONSULTANTS PROJECT No.: 1559-03

DRAWN: KP  
 CHECKED: TAF  
 ENGINEER: TAF

DATE: AUG 2021  
 SCALES: 1:500  
 SCALES: HALF 1:1000

PERMIT TO PRACTICE NO. 100275

ABORIGINAL HOUSING SOCIETY  
 OF PRINCE GEORGE  
 1919 17th AVENUE  
 4 LOT SUBDIVISION

CATCHMENT PLAN


DRAWING No.  
**C006-RD**

THE SEAL AND SIGNATURE OF THE UNDERSIGNED ON THIS DRAWING CERTIFIES THAT THE DESIGN INFORMATION CONTAINED IN THESE DRAWINGS ACCURATELY REFLECTS THE ORIGINAL DESIGN AND THE MATERIAL DESIGN CHANGES MADE DURING CONSTRUCTION. THAT WERE BROUGHT TO THE UNDERSIGNED'S ATTENTION. THESE DRAWINGS ARE INTENDED TO INCORPORATE ADDENDA, CHANGE ORDERS AND OTHER MATERIAL DESIGN CHANGES, BUT NOT NECESSARILY ALL SITE INSTRUCTIONS. THE UNDERSIGNED DOES NOT WARRANT OR GUARANTEE, NOR ACCEPT ANY RESPONSIBILITY FOR THE ACCURACY OR COMPLETENESS OF THE AS-CONSTRUCTED INFORMATION SUPPLIED BY OTHERS CONTAINED IN THESE DRAWINGS, BUT DOES, BY SEALING AND SIGNING, CERTIFY THAT THE AS CONSTRUCTED INFORMATION, IF ACCURATE AND COMPLETE, PROVIDES AN AS-CONSTRUCTED SYSTEM WHICH SUBSTANTIALLY COMPLIES IN ALL MATERIAL RESPECTS WITH THE ORIGINAL DESIGN INTENT.

G:\Job Files\1559\1559 - Aboriginal Housing Society of Prince George\03 - 17th Avenue - Village Subdivision\A - Block\0320 - 1559-03 - Record.dwg  
 25/01/2023 15:59

The City of Prince George does not represent or guarantee that the information contained in this document is accurate or reliable, and any person who relies on this information in this document does so at their own risk.

City of Prince George  
 This information has been provided subject to the Federal Copyright Act and in accordance with the Provincial Freedom of Information and Protection of Privacy Act.

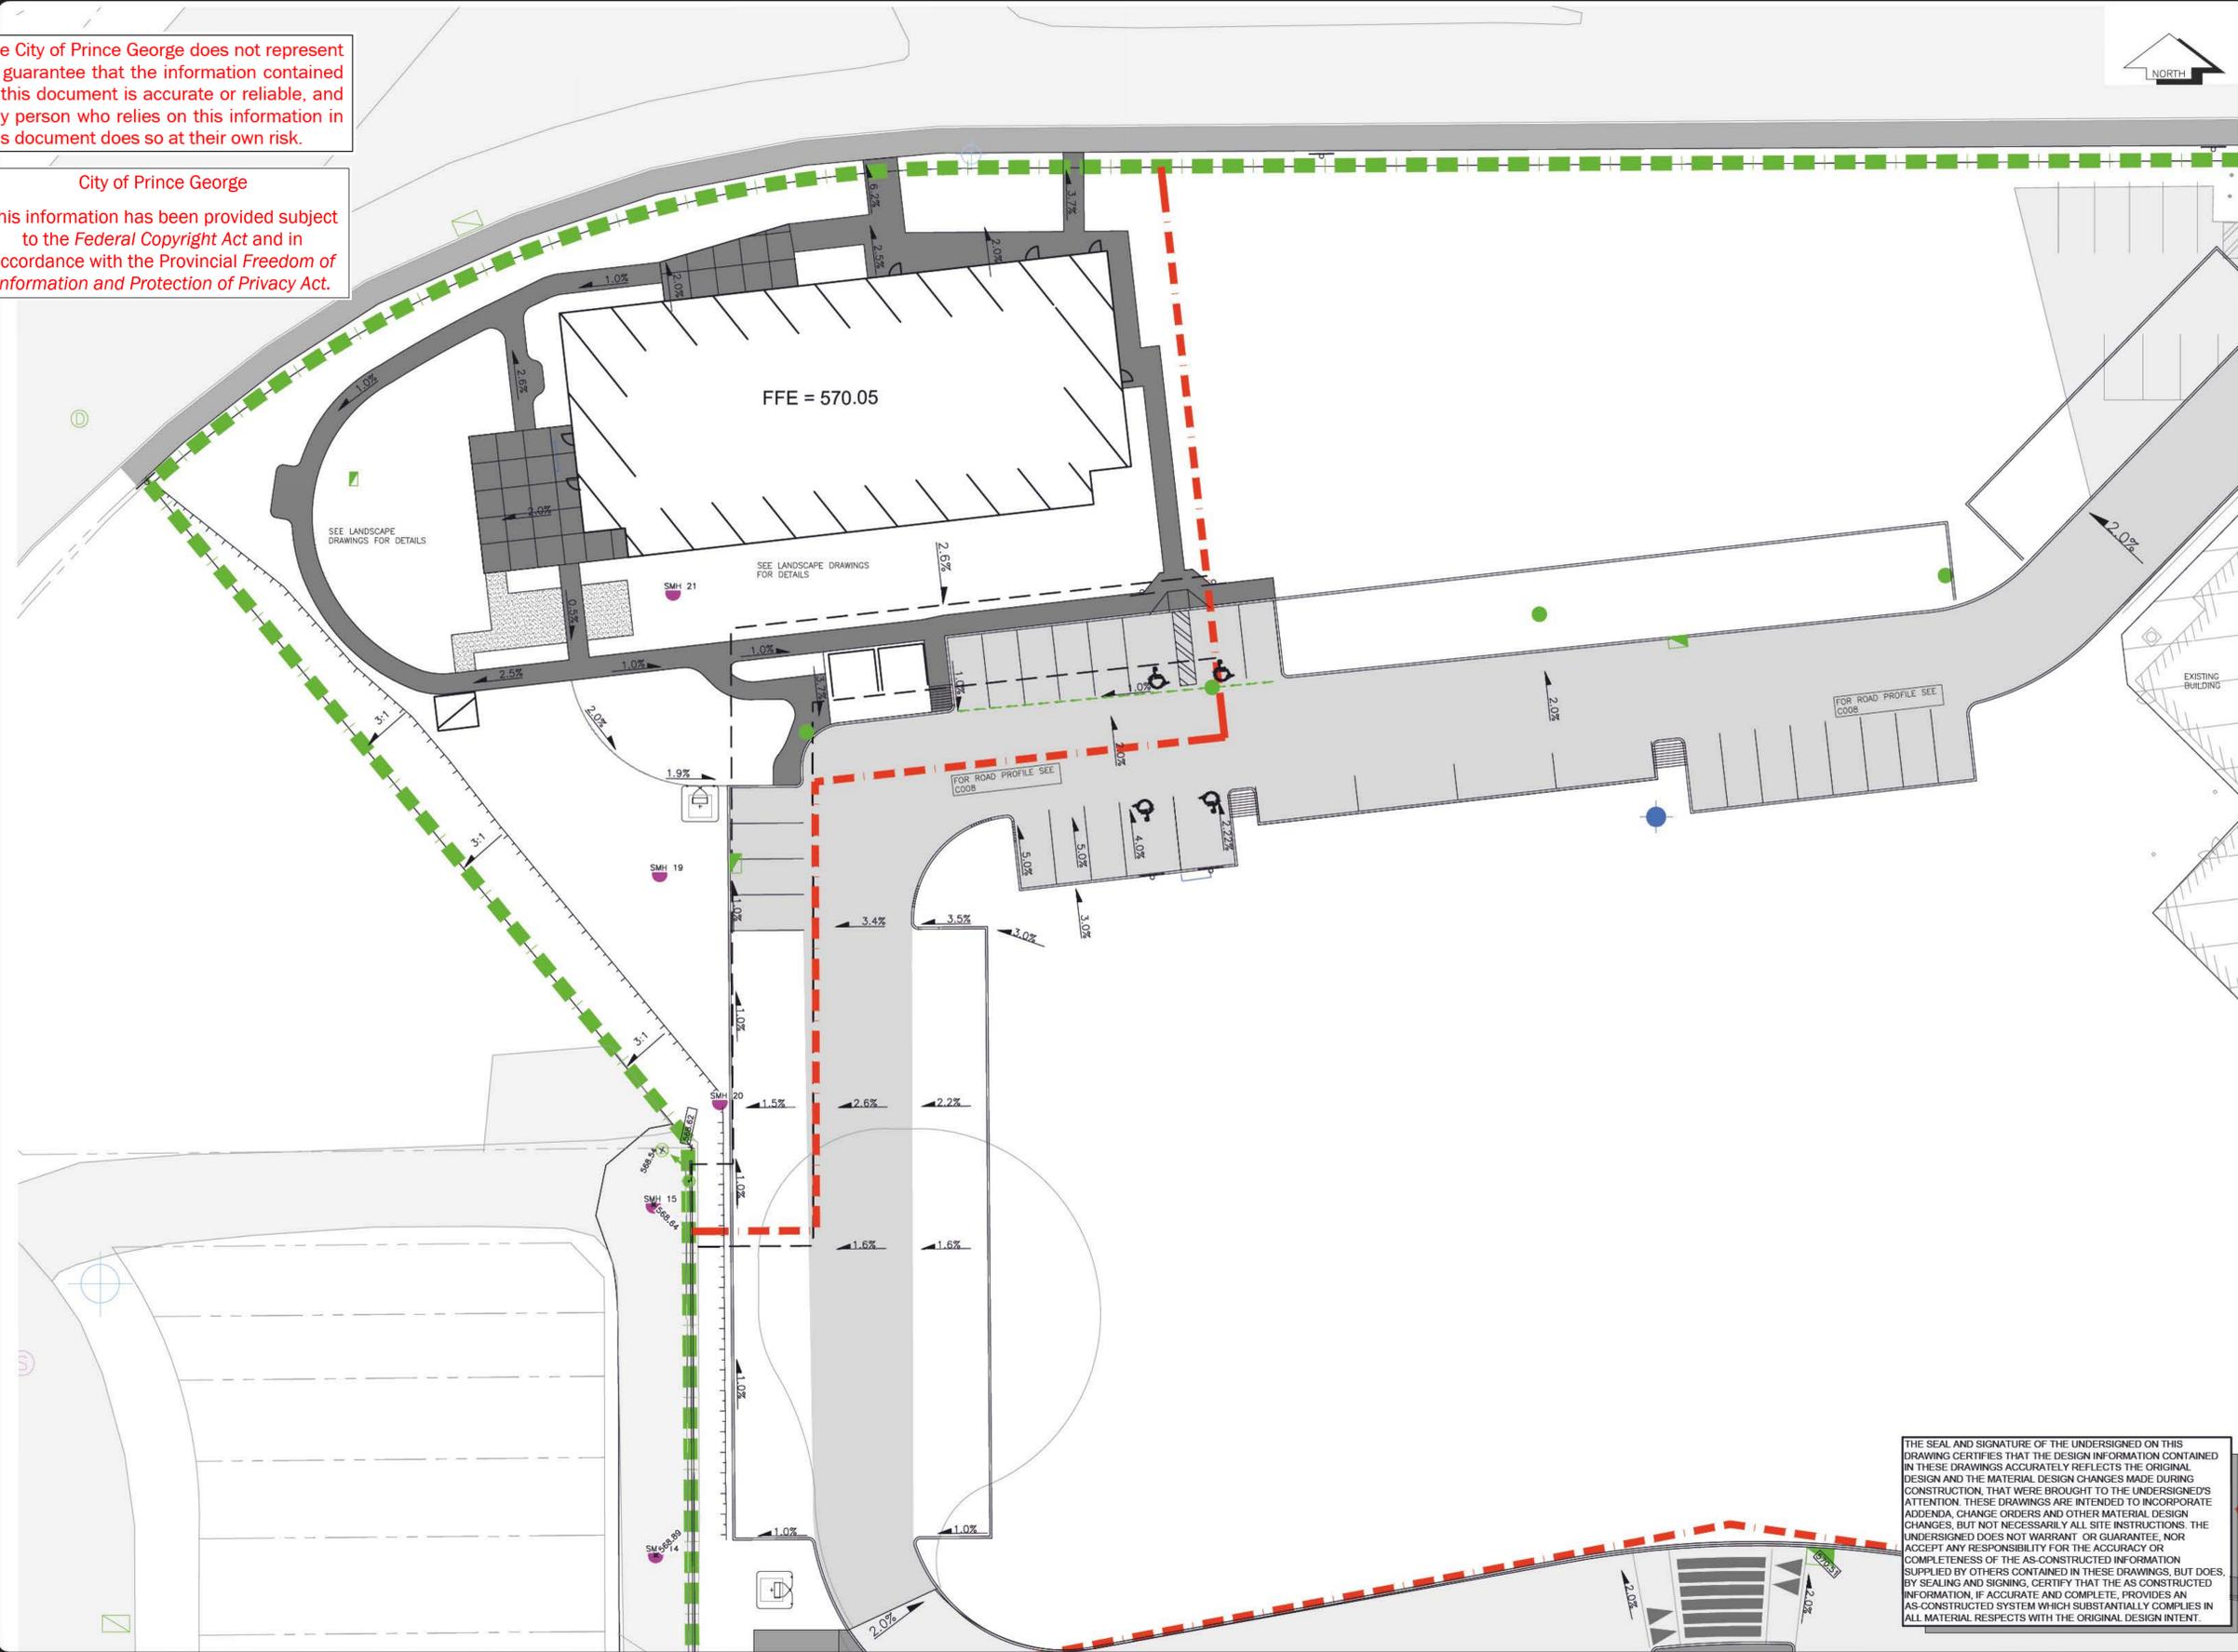

### LEGEND

EXISTING	
	EX. IP's & ISM's
	EX. LEGAL LINE
	EX. LEGAL R.O.W. & EASEMENT
	EX. SANITARY & MANHOLE
	EX. SANITARY FORCE MAIN
	EX. STORM & MANHOLE
	EX. SINGLE & DOUBLE CATCHBASIN w/ CB LEADS
	EX. CATCHBASIN MANHOLE
	EX. FIRE HYDRANT & VALVE ASSEMBLY
	EX. WATERMAIN & VALVE
	EX. BLOW-OFF ASSEMBLY
	EX. CURB STOP
	EX. ROAD & SIDEWALK
	EX. ROAD SIGN(S)
	EX. SHOULDER
	EX. TOP OF SLOPE
	EX. TOE OF SLOPE
	EX. DITCH or SWALE
	EX. FENCE
	EX. OVERHEAD LINES
	EX. UNDERGROUND LINES
	EX. POWER POLE & ANCHOR
	EX. GAS MAIN

ASBUILT	
	AS. LEGAL LOT
	AS. SANITARY & MANHOLE
	AS. STORM & MANHOLE
	AS. SINGLE & DOUBLE CATCHBASIN w/ CB LEADS
	AS. CATCHBASIN MANHOLE
	AS. FIRE HYDRANT & VALVE ASSEMBLY
	AS. WATERMAIN & VALVE
	AS. GRAVEL SHOULDER
	AS. ASPHALT
	AS. CURB & SIDEWALK
	AS. ROAD SIGN(S)

NO.	DATE (D/M/Y)	REVISION	BY
6	16/01/23	RECORD DRAWING	JET
5	30/8/21	ISSUED FOR CONSTRUCTION	KP
4	6/7/21	ISSUED FOR BLDG PERMIT	KP
3	11/6/21	ISSUED FOR CONSTRUCTION	KP
2	25/5/21	ISSUED FOR BP COORD	KP

RECORD DRAWING




CONSULTANTS PROJECT No.:	1352-71
DRAWN:	KP
CHECKED:	TAF
ENGINEER:	TAF
DATE:	MAR 2021
SCALES:	1:200
SCALES:	HALF 1:400

PERMIT TO PRACTICE NO 1002375

ABORIGINAL HOUSING SOCIETY  
 OF PRINCE GEORGE  
 17TH AVENUE VILLAGE  
 PHASE 3  
 GRADING PLAN

DRAWING No.  
**C003**

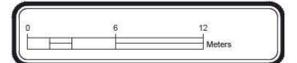

THE SEAL AND SIGNATURE OF THE UNDERSIGNED ON THIS DRAWING CERTIFIES THAT THE DESIGN INFORMATION CONTAINED IN THESE DRAWINGS ACCURATELY REFLECTS THE ORIGINAL DESIGN AND THE MATERIAL DESIGN CHANGES MADE DURING CONSTRUCTION, THAT WERE BROUGHT TO THE UNDERSIGNED'S ATTENTION. THESE DRAWINGS ARE INTENDED TO INCORPORATE ADDENDA, CHANGE ORDERS AND OTHER MATERIAL DESIGN CHANGES, BUT NOT NECESSARILY ALL SITE INSTRUCTIONS. THE UNDERSIGNED DOES NOT WARRANT OR GUARANTEE, NOR ACCEPT ANY RESPONSIBILITY FOR THE ACCURACY OR COMPLETENESS OF THE AS-CONSTRUCTED INFORMATION SUPPLIED BY OTHERS CONTAINED IN THESE DRAWINGS, BUT DOES, BY SEALING AND SIGNING, CERTIFY THAT THE AS-CONSTRUCTED INFORMATION, IF ACCURATE AND COMPLETE, PROVIDES AN AS-CONSTRUCTED SYSTEM WHICH SUBSTANTIALLY COMPLIES IN ALL MATERIAL RESPECTS WITH THE ORIGINAL DESIGN INTENT.

G:\Job Files\1352-71 - ASHG Phase 3 Design build\A-Building\1352-71\_00\_Grading.dwg

THIS DRAWING, AS AN INSTRUMENT OF SERVICE, IS THE PROPERTY OF L&M ENGINEERING LIMITED AND MAY NOT BE REPRODUCED WITHOUT WRITTEN PERMISSION OF SAME AND UNLESS THE REPRODUCTION CARRIES THEIR NAME. ALL DESIGNS AND OTHER INFORMATION SHOWN ON THIS DRAWING ARE FOR USE ON THE SPECIFIED PROJECT ONLY AND SHALL NOT BE USED OTHERWISE WITHOUT WRITTEN PERMISSION OF L&M ENGINEERING LIMITED.