

City of Prince George

HISTORY SHEET

PID: **028330994**

Scale: 1:500

Legal: Lot 18

D.L.: 2014

PLAN: EPP5390

Address: - 7588 & 7592 Creekside Way

Sanitary Connection:# SIZE: 100mmØ MATERIAL: PVC INV. 583.42 CONNECTED

Water Connection:# SIZE: 19mmØ MATERIAL: copper INV. 583.09 METER

Storm Connection:# SIZE 100mmØ MATERIAL PVC INV. 582.97 CONNECTED

Cash Receipt No's: WATER SANITARY STORM

CURB FROM PROPERTY LINE 5m PAVEMENT WIDTH 10m

B.C. HYDRO 75mm DB2 U/G CONNECTION ✓


B.C. TELEPHONE 50mm DB2 U/G CONNECTION ✓

TERASEN 42 PROP/P.E.

Information Sheets: REFERENCE DRAWINGS L&M ENGINEERING LIMITED JOB NO. 1140-07-04

Comments: CS CURB STOP SDW WATER SERVICE TCH HYDRO SERVICE GAS GAS
 CO CLEAN OUT STORM SERVICE CABLE SERVICE E ELECTRICAL
 SANITARY SERVICE TELECOMMUNICATIONS

**THE INFORMATION CONTAINED HEREIN IS FOR INTERNAL USE ONLY.
 NOT TO BE RELIED UPON UNLESS CONFIRMED BY THE SITE INSPECTION AND/OR INVESTIGATION**

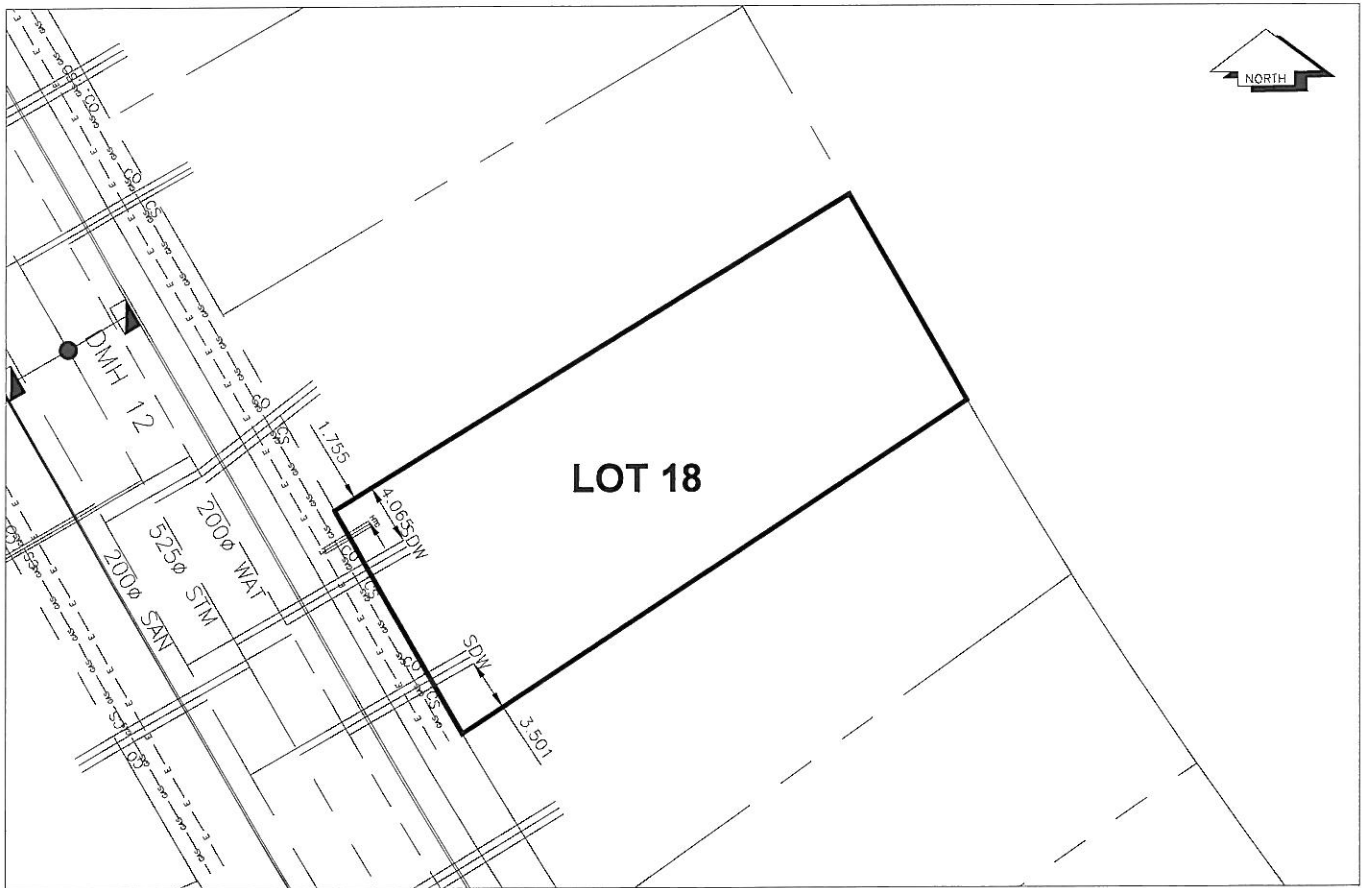

SANITARY, STORM & WATER SERVICE INVERTS NORTH	SANITARY	WATER	STORM
1. Distance from San. M.H. <u>08</u> toward San. M.H. <u>09</u> to lot service connection point is:	65m	N/A	N/A
1a.Distance from Stm. M.H. <u>11</u> toward Stm. M.H. <u>13</u> to lot service connection point is:	N/A	N/A	23m
2. Main Size at connection point is	200mmØ	200mmØ	525mmØ
3. Invert of main at conn. stub point is	582.73	582.06	582.07
4. Invert at service end is	583.42	583.15	582.97
5. Cut at property line in meters	2.59m	3.00m	3.04m
6. Survey Date: OCT 2009 Book Ref.: 1140-07-04 By: FORESIGHT SURVEY & DESIGN			

SANITARY, STORM & WATER SERVICE INVERTS SOUTH	SANITARY	WATER	STORM
1. Distance from San. M.H. <u>08</u> toward San. M.H. <u>09</u> to lot service connection point is:	73m	N/A	N/A
1a.Distance from Stm. M.H. <u>12</u> toward Stm. M.H. <u>13</u> to lot service connection point is:	N/A	N/A	31m
2. Main Size at connection point is	200mmØ	200mmØ	525mmØ
3. Invert of main at conn. stub point is	582.89	582.02	582.19
4. Invert at service end is	583.38	583.47	583.26
5. Cut at property line in meters	2.56m	2.55m	2.68m
6. Survey Date: OCT 2009 Book Ref.: 1140-07-04 By: FORESIGHT SURVEY & DESIGN			

SANITARY HISTORY:

Installed By: Fortwood Homes Ltd.

WATER HISTORY:

Installed By: Fortwood Homes Ltd.

STORM HISTORY:

Installed By: Fortwood Homes Ltd.
