

# City of Prince George

## HISTORY SHEET

PID: 028353641

Scale: 1:500

Legal: LOT 34

D.L.: 2003

PLAN: BCP46243

Address: 2684 MAURICE DR

Sanitary Connection:#                      SIZE: 100mmØ                      MATERIAL: PVC                      INV. 718.64                      CONNECTED

Water Connection:#                      SIZE: 19mmØ                      MATERIAL: Copper                      INV. 718.64

Storm Connection:#                      SIZE 100mmØ                      MATERIAL PVC                      INV. 718.64                      CONNECTED

Cash Receipt No's:                      WATER                      SANITARY                      STORM

CURB FROM PROPERTY LINE                      5m                      PAVEMENT WIDTH                      10m

HYDRO                      75mm DB2                      U/G CONNECTION                      ✓


TELEPHONE                      100mm DB2                      U/G CONNECTION                      ✓

GAS                      42 PROP/P.E.

Information Sheets:                      REF. DWGS. L&M ENGINEERING LTD. JOB. 1273-05-04 DWGS. (001-307)

Comments:                      CS CURB STOP                      SDW WATER SERVICE                      TCH HYDRO SERVICE                      GAS GAS  
                     CO CLEAN OUT                      STORM SERVICE                      CABLE SERVICE                      E ELECTRICAL  
                     SANITARY SERVICE                      TELECOMMUNICATIONS

**THE INFORMATION CONTAINED HEREIN IS FOR INTERNAL USE ONLY.  
 NOT TO BE RELIED UPON UNLESS CONFIRMED BY THE SITE INSPECTION AND/OR INVESTIGATION**

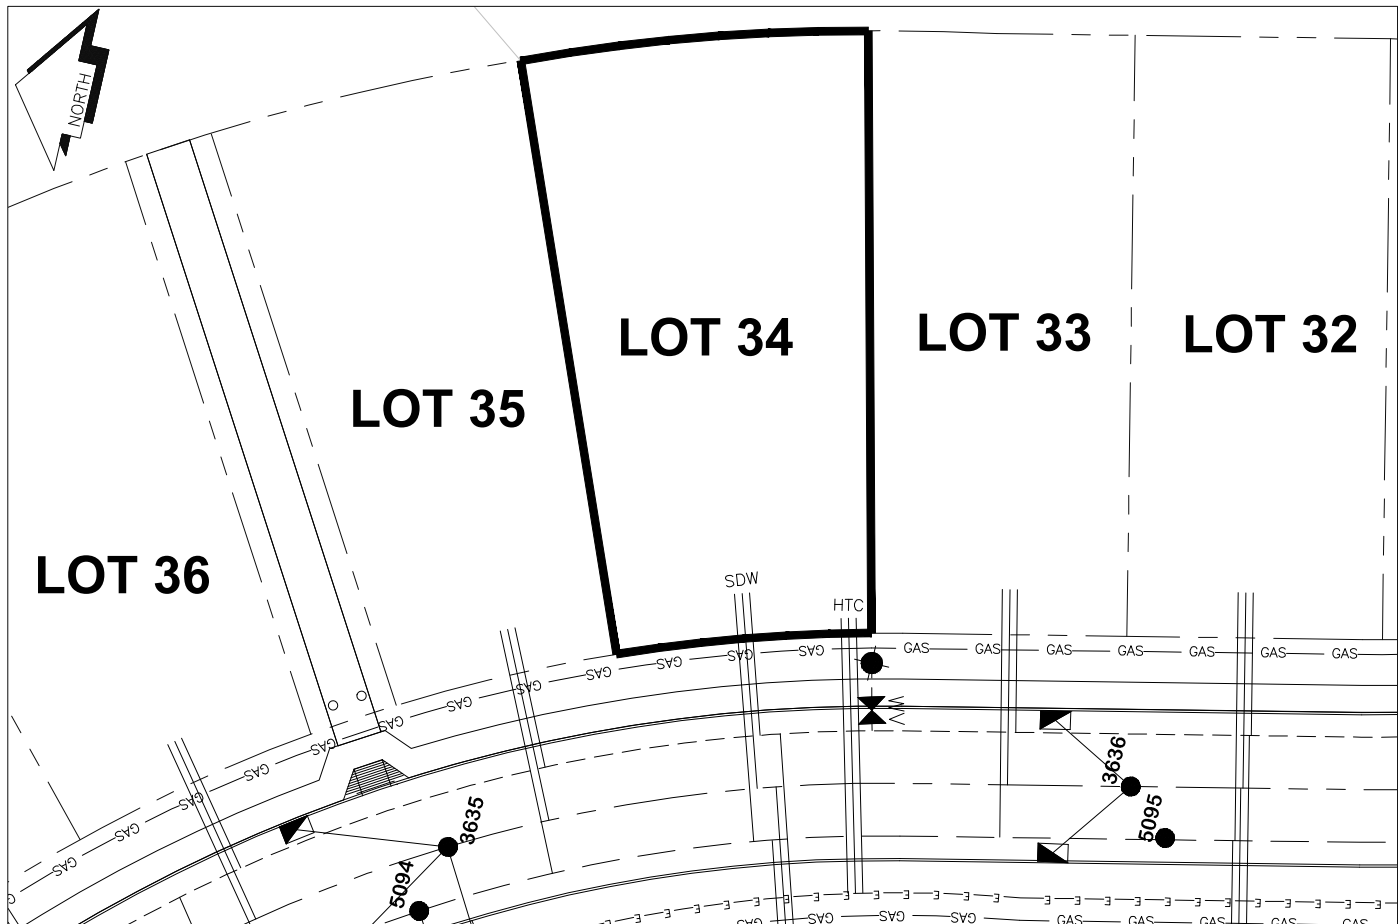

SANITARY, STORM & WATER SERVICE INVERTS	SANITARY	WATER	STORM
1. Distance from San. M.H. 5094 toward San. M.H. 5095 to lot service connection point is:	23m	N/A	N/A
1a. Distance from Stm. M.H. 3635 toward Stm. M.H. 3636 to lot service connection point is:	N/A	N/A	21m
2. Main Size at connection point is	200mmØ	200mmØ	525mmØ
3. Invert of main at conn. stub point is	717.22	717.52	716.86
4. Invert at service end is	718.92	718.91	718.91
5. Cover at property line in meters	2.27m	2.35m	2.27m
6. Survey Date: MAY 2010 Book Ref.: 1273-05-03 By: PIERRE DORION			

**SANITARY HISTORY:**

DATE INSTALLED: JUNE 2010

INSTALLED BY: PROGRESSIVE CONTRACTORS LTD.

**WATER HISTORY:**

DATE INSTALLED: JUNE 2010

INSTALLED BY: PROGRESSIVE CONTRACTORS LTD.

**STORM HISTORY:**

DATE INSTALLED: JUNE 2010

INSTALLED BY: PROGRESSIVE CONTRACTORS LTD.