


# PGMap

Addresses

Regional District Roads

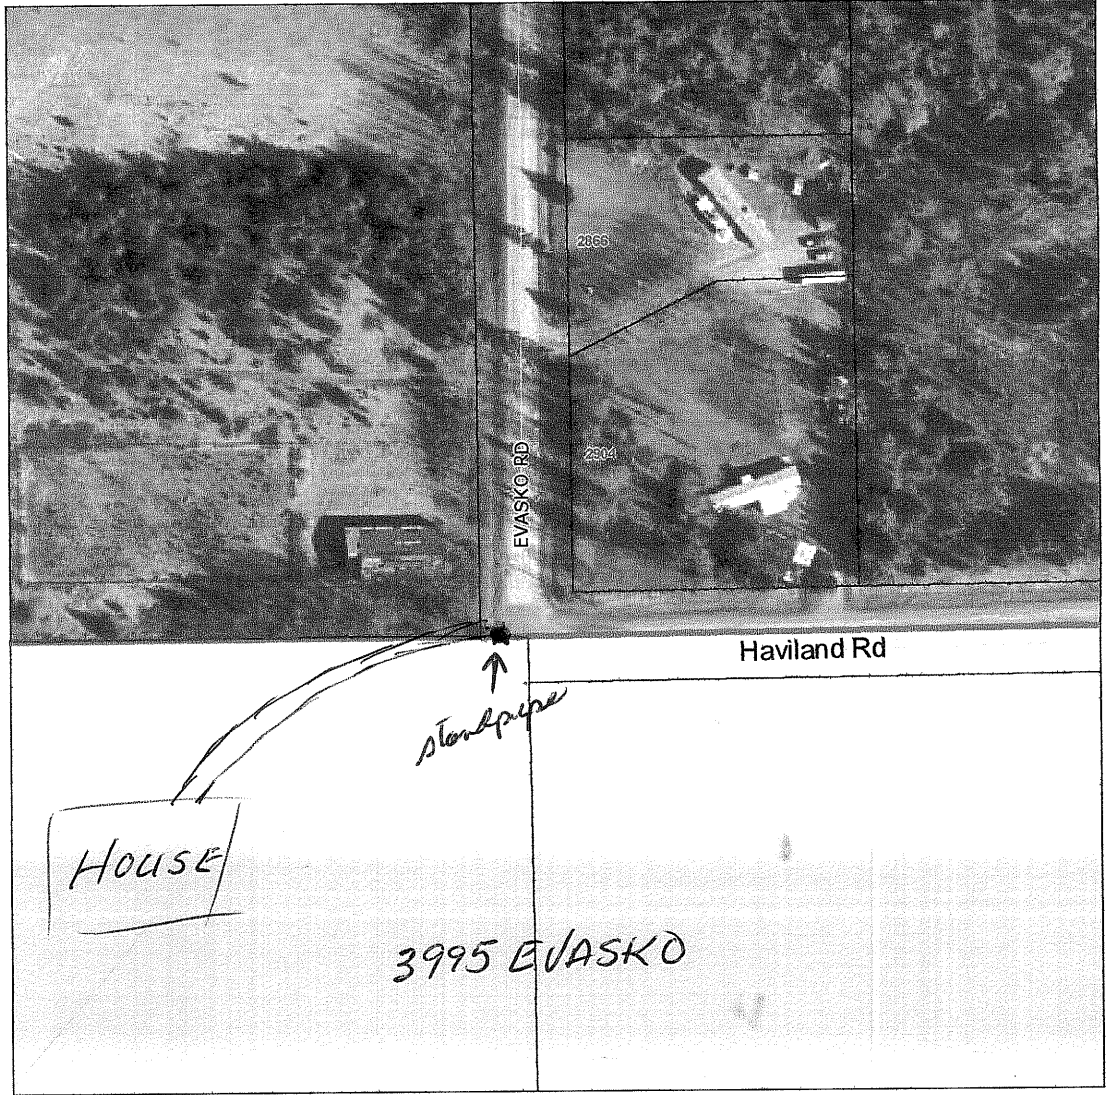

SCALE 1 : 1,684

