

**City of Prince George
HISTORY SHEET**

003920921
003961168

SHEET NUMBER **No 1870** Roll Number

Legal: LOT'S **3,4** BLOCK **317** D.L. **343** PLAN **1268**

Address: **1829 REDWOOD STREET**

Sanitary Connection: # **4443** SIZE **4"** MATERIAL **AC.S.** INV. **CONNECTED**

Water Connection # **4211** SIZE **3/4"** MATERIAL **COPPER** METER **CONNECTED**

Storm Connection: # _____ SIZE _____ MATERIAL _____ INV. **CONNECTED**

Cash Receipt No's: WATER _____ SANITARY _____ STORM _____

CURB FROM PROPERTY LINE _____ PAVEMENT WIDTH _____

B.C. HYDRO _____ UNDERGROUND CONNECTION _____



B.C. TELEPHONE _____ UNDERGROUND CONNECTION _____

INLAND GAS _____

Information Sheets: _____

Comments: _____

SITE PLAN N.T.S.

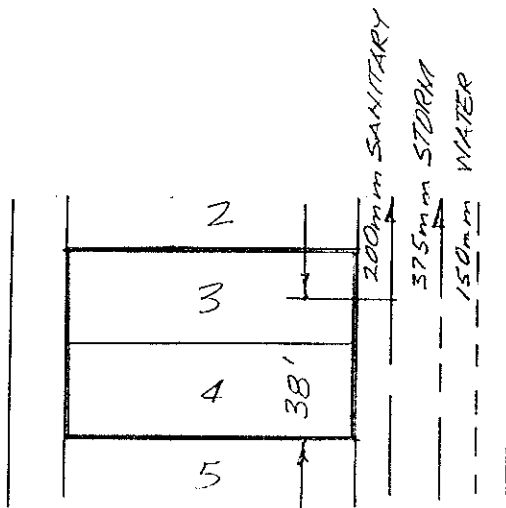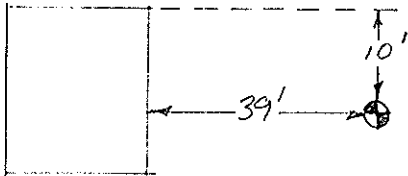

REDWOOD