



City of Prince George
History Sheet

PID:	005092990
	005092965
SD/MU:	
WO:	

Civic Address: 592 Ewert St

Legal Description: Lot: 23, 24 Block: 32 District Lot: 937 Plan: 752


Service Type	Diameter (mm)	Material	Invert Elev at main (m)	Invert Elev at property line (m)	Invert Depth at service end (m)	Distance into property (m)	Installation Date
Sanitary	100mm	AC	588.18	588.29	2.00	-	December 1960
Water	20mm	Copper	-	-	-	-	December 1959
Storm	N/A	N/A	-	-	-	-	

Service Connection Location				Sanitary (m)	Storm (m)
Distance from downstream San MH	2666	towards upstream San MH	981	24.74	
Distance from downstream Stm MH	-	towards upstream Stm MH	-		

Power	Size	Communications	Size	Cable	Size	Gas	Size
BC Hydro	-	Telus	-	Shaw	-	FortisBC	-
Overhead Service		Overhead Service		Overhead Service			

Installed by:		Survey Date:	-
Comments:	Water service connection confirmed June 2018,		

NOT TO SCALE The information contained herein is for internal use only.
Not to be relied on unless confirmed by site inspection and/or investigation.

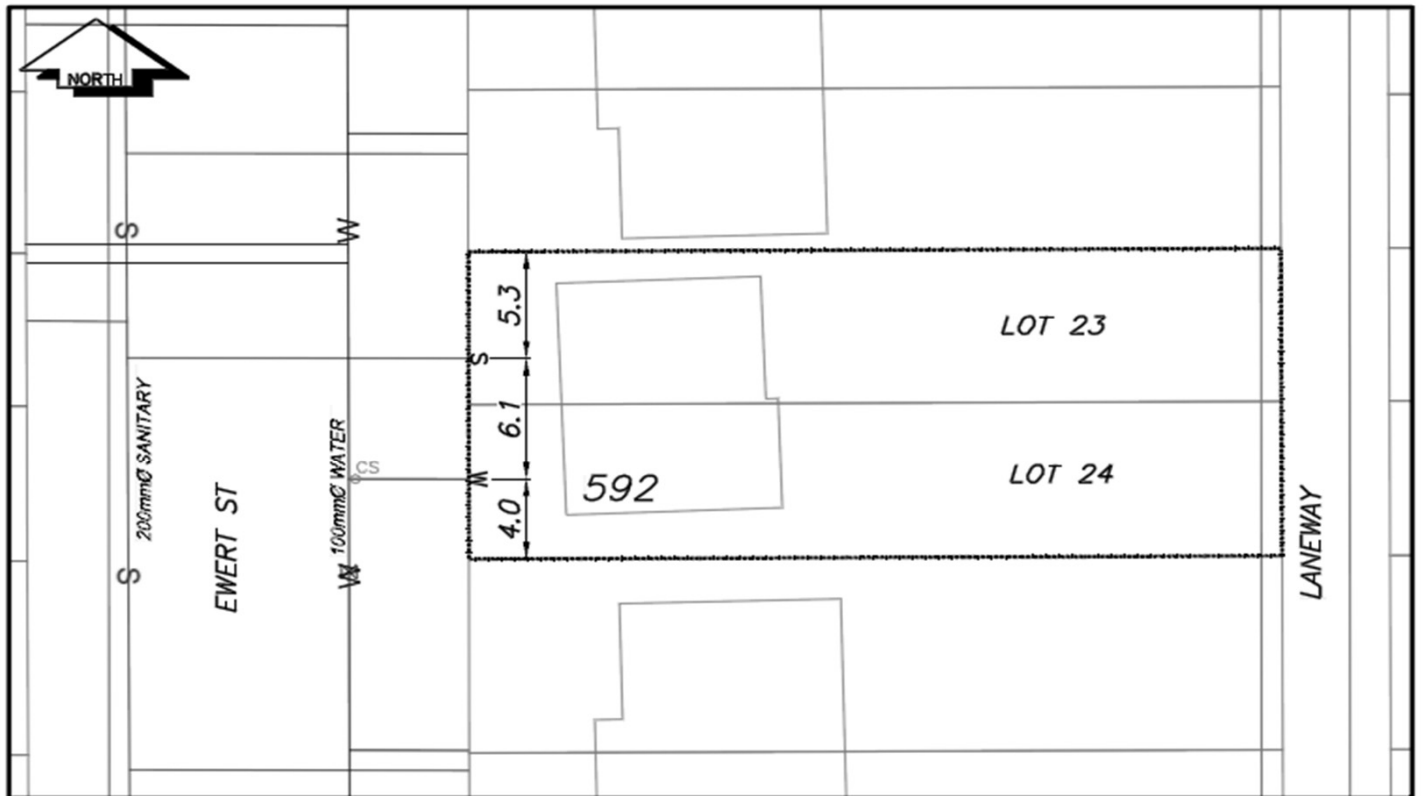

LEGEND:	
CURB STOP	WATER SERVICE
CLEAN OUT	SANITARY SERVICE
WATER VALVE	FIRE HYDRANT
	STORM SERVICE
	GAS
	ENCUMBRANCE

NOT TO SCALE