

**City of Prince George
HISTORY SHEET**

05268510
320
346

SHEET NUMBER

Roll Number

Legal: LOT'S 6-7-B BLOCK 70 D.L. 937 PLAN 752

Address: 337 KELLY ST.

Sanitary Connection: # 3104 SIZE 100mm MATERIAL A.C. INV. 598.068 CONNECTED

Water Connection # 3185 SIZE 20mm MATERIAL C.U. METER CONNECTED

Storm Connection: # _____ SIZE _____ MATERIAL _____ INV. _____ CONNECTED

Cash Receipt No's: WATER _____ SANITARY _____ STORM _____

CURB FROM PROPERTY LINE 4.877 m PAVEMENT WIDTH 10.363 m


B.C. HYDRO O/H UNDERGROUND CONNECTION

B.C. TELEPHONE O/H UNDERGROUND CONNECTION



INLAND GAS 1.524 m FROM WEST SIDE OF LANE.

Information Sheets:

Comments:

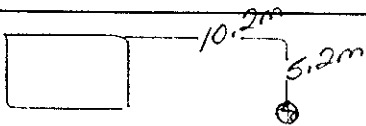

SITE PLAN N.T.S.

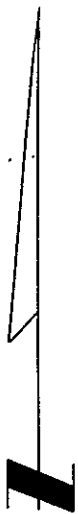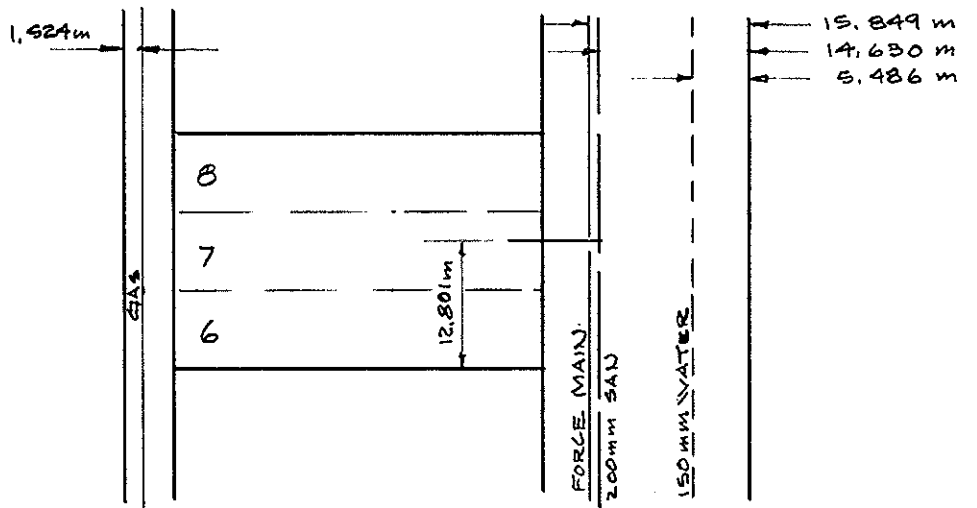

KELLY ST.