

City of Prince George

HISTORY SHEET

PID: - 028611985

Scale: 1:500

Legal: LOT 1

D.L.: 1599

PLAN: EPP9175


Address:- 8244 BUNCE RD

Sanitary Connection:#	SIZE: 100mmØ	MATERIAL: PVC	INV. 738.07m	CONNECTED
Water Connection:#	SIZE: 19mmØ	MATERIAL: PVC	INV. 738.09m	
Storm Connection:#	SIZE 100mmØ	MATERIAL PVC	INV. 738.10m	CONNECTED
Cash Receipt No's:	WATER	SANITARY	STORM	
CURB FROM PROPERTY LINE	4m	PAVEMENT WIDTH	8.75m	
HYDRO	75mm DB2	U/G CONNECTION	✓	
TELEPHONE	50mm DB2	U/G CONNECTION	✓	
GAS	42 PROP /P.E			

Information Sheets: REF. DWGS. L&M ENGINEERING LTD. JOB. 1014-192-04 DWGS (001-205)

Comments: CS CURB STOP SDW WATER SERVICE CH HYDRO SERVICE GAS
CO CLEAN OUT STS STORM SERVICE CCH CABLE SERVICE ELECTRICAL
SANITARY SERVICE TCH TELECOMMUNICATIONS

**THE INFORMATION CONTAINED HEREIN IS FOR INTERNAL USE ONLY.
NOT TO BE RELIED UPON UNLESS CONFIRMED BY THE SITE INSPECTION AND/OR INVESTIGATION**

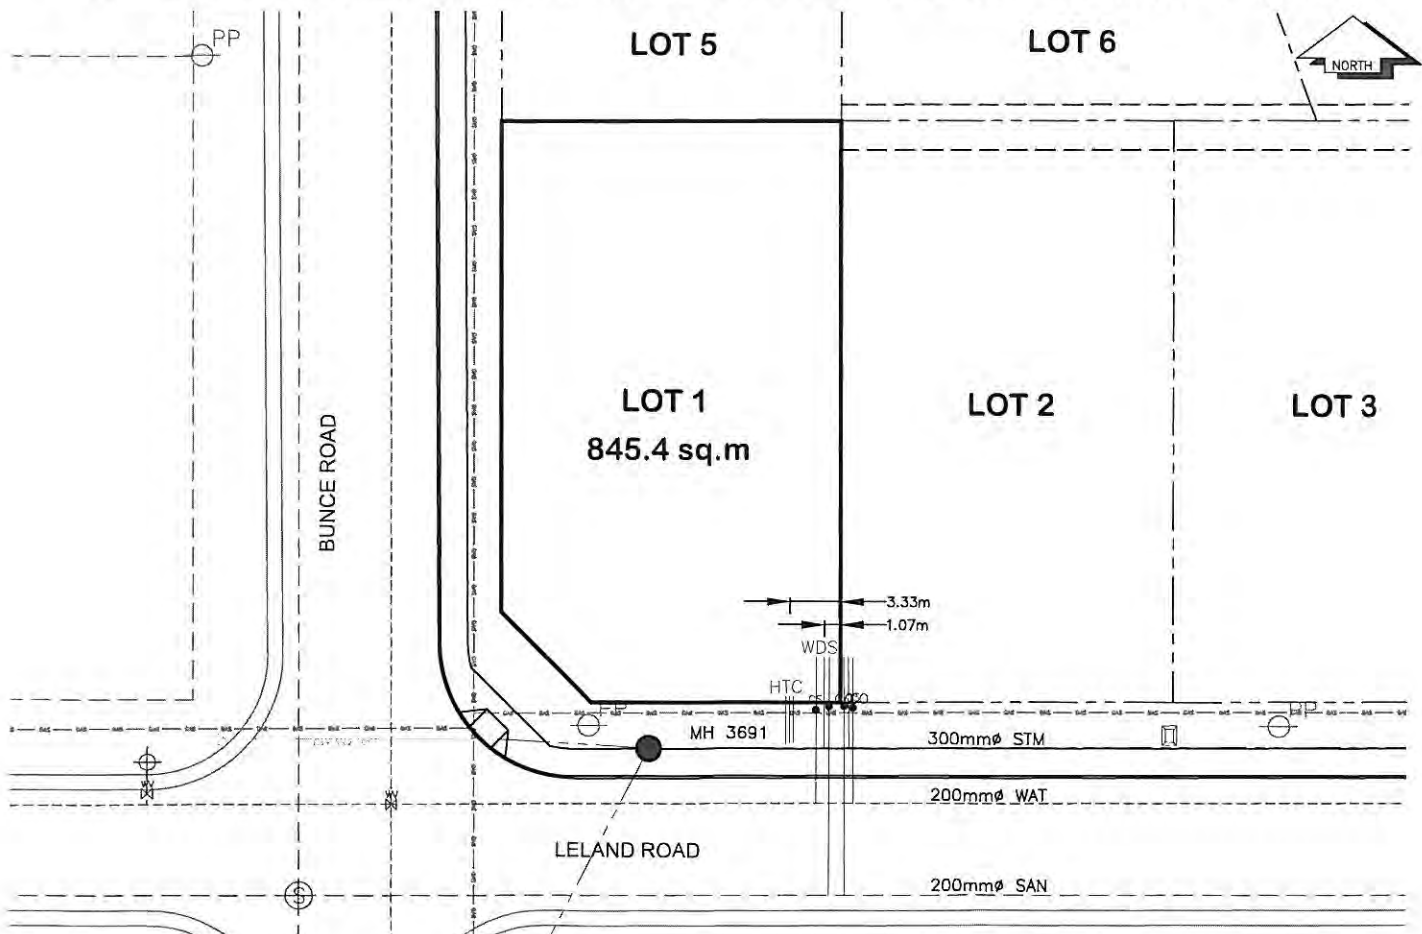

SANITARY, STORM & WATER SERVICE INVERTS	SANITARY	WATER	STORM
1. Distance from San. M.H. <u>B-5</u> toward San. M.H. <u>L-2</u> to lot service connection point is:	34.9m	N/A	N/A
1a.Distance from Stm. M.H. <u>3691</u> toward Stm. M.H. <u>3690</u> to lot service connection point is:	N/A	N/A	11.9m
2. Main Size at connection point is	200mmØ	200mmØ	300mmØ
3. Invert of main at conn. stub point is	737.53m	737.57m	737.84m
4. Invert at service end is	738.33m	738.21m	738.34m
5. Cover at property line in meters	2.43m	2.41m	2.40m
6. Survey Date <u>NOV 2010</u> Book Ref.: <u>1014-192-0</u> By: <u>FORESIGHT</u>			

SANITARY HISTORY:

DATE INSTALLED: SEPTEMBER 2010

INSTALLED BY: WESTERN INDUSTRIAL CONTRACTORS LTD.

WATER HISTORY:

DATE INSTALLED: SEPTEMBER 2010

INSTALLED BY: WESTERN INDUSTRIAL CONTRACTORS LTD.

STORM HISTORY:

DATE INSTALLED: SEPTEMBER 2010

INSTALLED BY: WESTERN INDUSTRIAL CONTRACTORS LTD.