

City of Prince George

HISTORY SHEET

PID: 028612027

Scale: 1:500

Legal: LOT 4

D.L.: 1599

PLAN: EPP9175

Address: 5872 LELAND RD

Sanitary Connection:# SIZE: 100mmØ MATERIAL: PVC INV. 737.57m CONNECTED

Water Connection:# SIZE: 19mmØ MATERIAL: PVC INV. 737.24m

Storm Connection:# SIZE: 100mmØ MATERIAL: PVC INV. 737.53m CONNECTED

Cash Receipt No's: WATER SANITARY STORM

CURB FROM PROPERTY LINE 4m PAVEMENT WIDTH 8.75m

HYDRO 75mm DB2 U/G CONNECTION ✓

TELEPHONE 50mm DB2 U/G CONNECTION ✓


GAS 42 PROP /P.E

Information Sheets: REF. DWGS. L&M ENGINEERING LTD. JOB. 1014-192-04 DWGS (001-205)

Comments: CS CURB STOP CO CLEAN OUT WDS WATER SERVICE SOW STORM SERVICE SCS SANITARY SERVICE HCS HYDRO SERVICE COT CABLE SERVICE TCT TELECOMMUNICATIONS GAS ELECTRICAL

THE INFORMATION CONTAINED HEREIN IS FOR INTERNAL USE ONLY.

NOT TO BE RELIED UPON UNLESS CONFIRMED BY THE SITE INSPECTION AND/OR INVESTIGATION

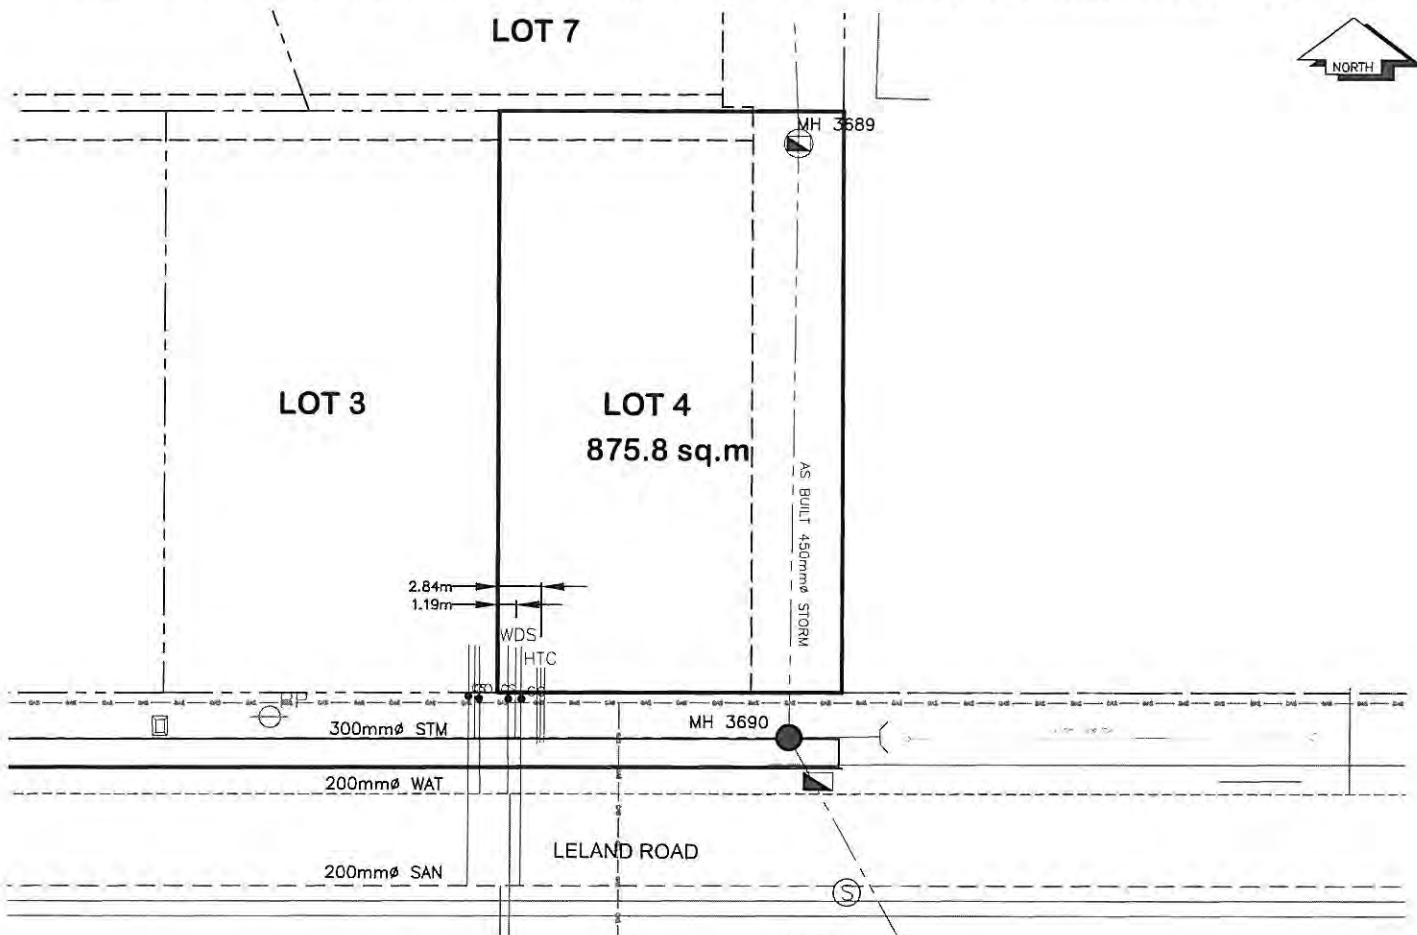

SANITARY, STORM & WATER SERVICE INVERTS	SANITARY	WATER	STORM
1. Distance from San. M.H. <u>L-2</u> toward San. M.H. <u>B-5</u> to lot service connection point is:	20.8m	N/A	N/A
1a.Distance from Stm. M.H. <u>3691</u> toward Stm. M.H. <u>3690</u> to lot service connection point is:	N/A	N/A	17.6m
2. Main Size at connection point is	200mmØ	200mmØ	300mmØ
3. Invert of main at conn. stub point is	737.10m	m	737.10m
4. Invert at service end is	737.75m	737.43m	737.74m
5. Cover at property line in meters	2.25m	2.58m	2.29m
6. Survey DateNOV 2010 Book Ref.: 1014-192-0 By: FORESIGHT			

SANITARY HISTORY:

DATE INSTALLED: SEPTEMBER 2010

INSTALLED BY: WESTERN INDUSTRIAL CONTRACTORS LTD.

WATER HISTORY:

DATE INSTALLED: SEPTEMBER 2010

INSTALLED BY: WESTERN INDUSTRIAL CONTRACTORS LTD.

STORM HISTORY:

DATE INSTALLED: SEPTEMBER 2010

INSTALLED BY: WESTERN INDUSTRIAL CONTRACTORS LTD.
