

City of Prince George

HISTORY SHEET

PID: 028612035

Scale: 1:500

Legal: LOT 5

D.L.: 1599

PLAN: EPP9175

Address:- 5813 VIRK PL


Sanitary Connection:#	SIZE: 100mmØ	MATERIAL: PVC	INV. EX	CONNECTED
Water Connection:#	SIZE: 19mmØ	MATERIAL: PVC	INV. EX	
Storm Connection:#	SIZE: 100mmØ	MATERIAL: PVC	INV. 737.95m	CONNECTED
Cash Receipt No's:	WATER	SANITARY	STORM	
CURB FROM PROPERTY LINE	5m	PAVEMENT WIDTH	10m	
HYDRO	75mm DB2	U/G CONNECTION	✓	
TELEPHONE	50mm DB2	U/G CONNECTION	✓	
GAS	42 PROP /P.E			

Information Sheets: REF. DWGS. L&M ENGINEERING LTD. JOB. 1014-192-04 DWGS (001-205)

Comments: CS CURB STOP CO CLEAN OUT WWS WATER SERVICE SWS STORM SERVICE SSS SANITARY SERVICE HCS HYDRO SERVICE CCS CABLE SERVICE TCS TELECOMMUNICATIONS GAS ELECTRICAL

THE INFORMATION CONTAINED HEREIN IS FOR INTERNAL USE ONLY.

NOT TO BE RELIED UPON UNLESS CONFIRMED BY THE SITE INSPECTION AND/OR INVESTIGATION

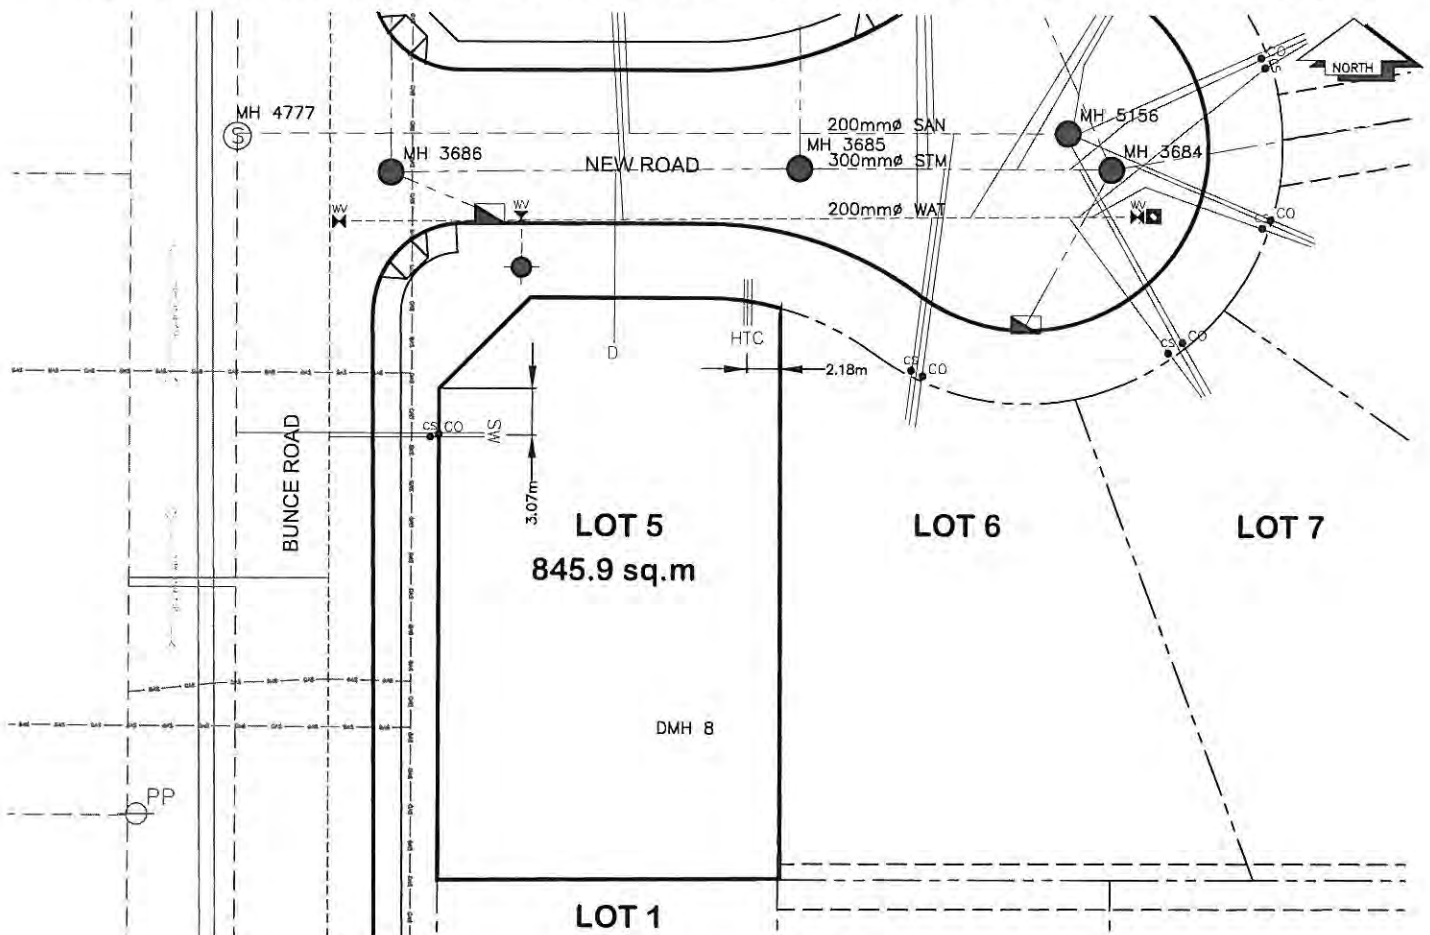

SANITARY, STORM & WATER SERVICE INVERTS	SANITARY	WATER	STORM
1. Distance from San. M.H. <u>4777</u> toward San. M.H. <u>B-5</u> to lot service connection point is:	19.62 m	N/A	N/A
1a. Distance from Stm. M.H. <u>3686</u> toward Stm. M.H. <u>3685</u> to lot service connection point is:	N/A	N/A	14.63 m
2. Main Size at connection point is	200mmØ	200mmØ	300mmØ
3. Invert of main at conn. stub point is	-	-	737.66m
4. Invert at service end is	-	-	738.10m
5. Cover at property line in meters	-	-	2.15m
6. Survey Date NOV 2010 Book Ref.: 1014-192-0 By: FORESIGHT			

SANITARY HISTORY:

DATE INSTALLED: SEPTEMBER 2010

INSTALLED BY: WESTERN INDUSTRIAL CONTRACTORS LTD.

WATER HISTORY:

DATE INSTALLED: SEPTEMBER 2010

INSTALLED BY: WESTERN INDUSTRIAL CONTRACTORS LTD.

STORM HISTORY:

DATE INSTALLED: SEPTEMBER 2010

INSTALLED BY: WESTERN INDUSTRIAL CONTRACTORS LTD.