

City of Prince George

HISTORY SHEET

PID: . 028612060

Scale: 1:500

Legal: LOT 8

D.L.: 1599

PLAN: EPP9175

Address:- 5885 VIRK PL

Sanitary Connection:# SIZE: 100mmØ MATERIAL: PVC INV. 737.24m CONNECTED

Water Connection:# SIZE: 19mmØ MATERIAL: PVC INV. 737.19m

Storm Connection:# SIZE: 100mmØ MATERIAL: PVC INV. 737.25m CONNECTED

Cash Receipt No's: WATER SANITARY STORM

CURB FROM PROPERTY LINE 5m PAVEMENT WIDTH 10m

HYDRO 75mm DB2 U/G CONNECTION ✓


TELEPHONE 50mm DB2 U/G CONNECTION ✓

GAS 42 PROP /P.E

Information Sheets: REF. DWGS. L&M ENGINEERING LTD. JOB. 1014-192-04 DWGS (001-205)

Comments: CS CURB STOP SDW WATER SERVICE TCH HYDRO SERVICE
CO CLEAN OUT STORM SERVICE CABLE SERVICE GAS
SANITARY SERVICE TELECOMMUNICATIONS ELECTRICAL

THE INFORMATION CONTAINED HEREIN IS FOR INTERNAL USE ONLY.
NOT TO BE RELIED UPON UNLESS CONFIRMED BY THE SITE INSPECTION AND/OR INVESTIGATION

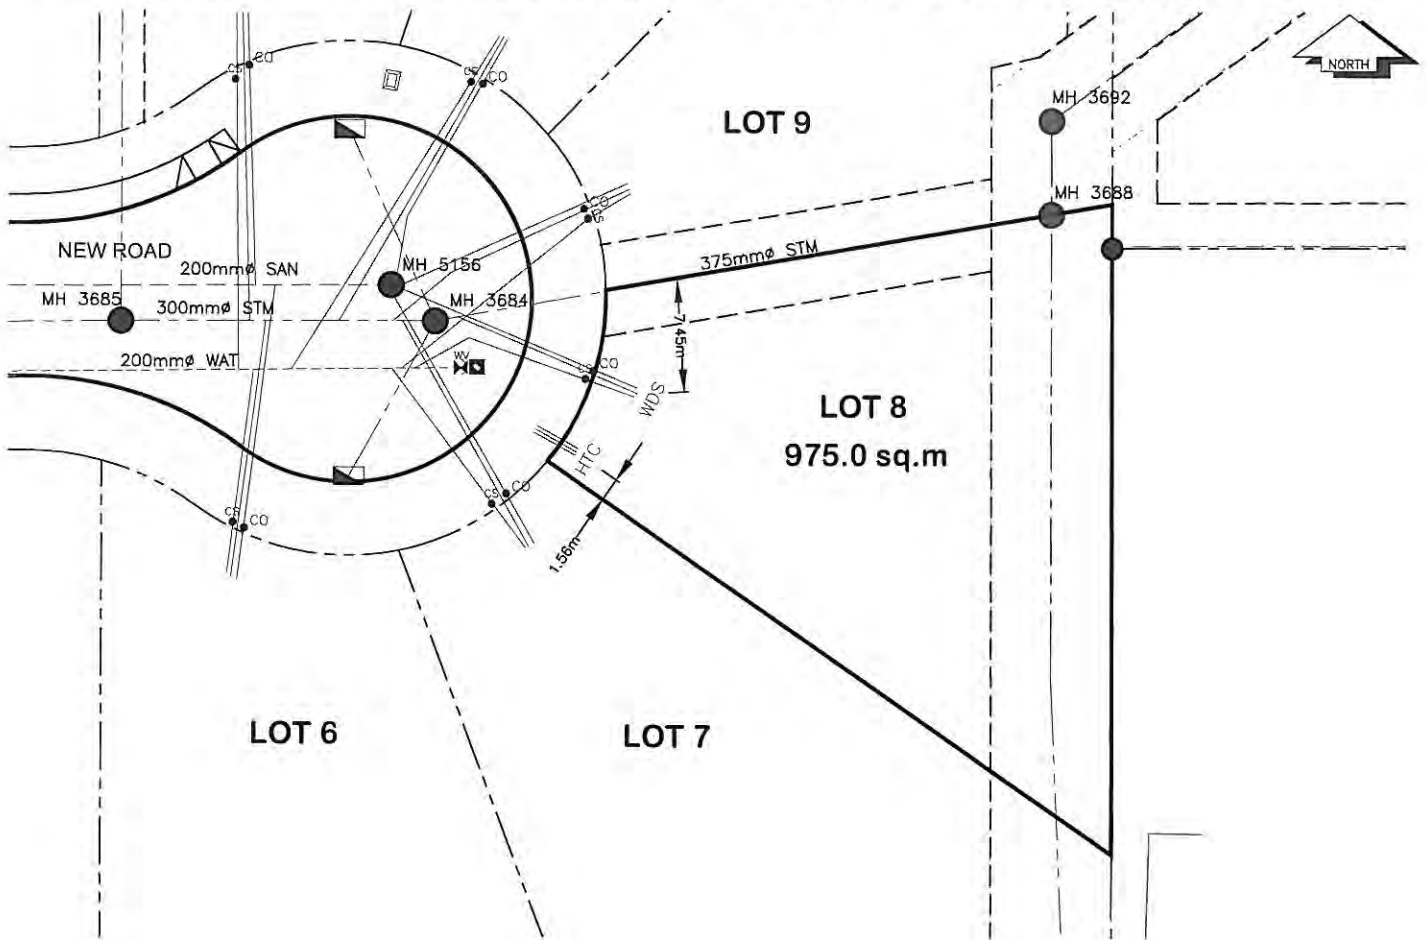

SANITARY, STORM & WATER SERVICE INVERTS	SANITARY	WATER	STORM
1. Distance from San. M.H. <u>5156</u> toward San. M.H. _____ to lot service connection point is:	0.0m	N/A	N/A
1a.Distance from Stm. M.H. <u>3684</u> toward Stm. M.H. _____ to lot service connection point is:	N/A	N/A	0.0m
2. Main Size at connection point is	200mmØ	200mmØ	300mmØ
3. Invert of main at conn. stub point is	736.89m	736.39m	736.80m
4. Invert at service end is	737.44m	737.30m	737.45m
5. Cover at property line in meters	2.26m	2.39m	2.25m
6. Survey Date <u>NOV 2010</u> Book Ref.: <u>1014-192-0</u> By: <u>FORESIGHT</u>			

SANITARY HISTORY:

DATE INSTALLED: SEPTEMBER 2010

INSTALLED BY: WESTERN INDUSTRIAL CONTRACTORS LTD.

WATER HISTORY:

DATE INSTALLED: SEPTEMBER 2010

INSTALLED BY: WESTERN INDUSTRIAL CONTRACTORS LTD.

STORM HISTORY:

DATE INSTALLED: SEPTEMBER 2010

INSTALLED BY: WESTERN INDUSTRIAL CONTRACTORS LTD.