



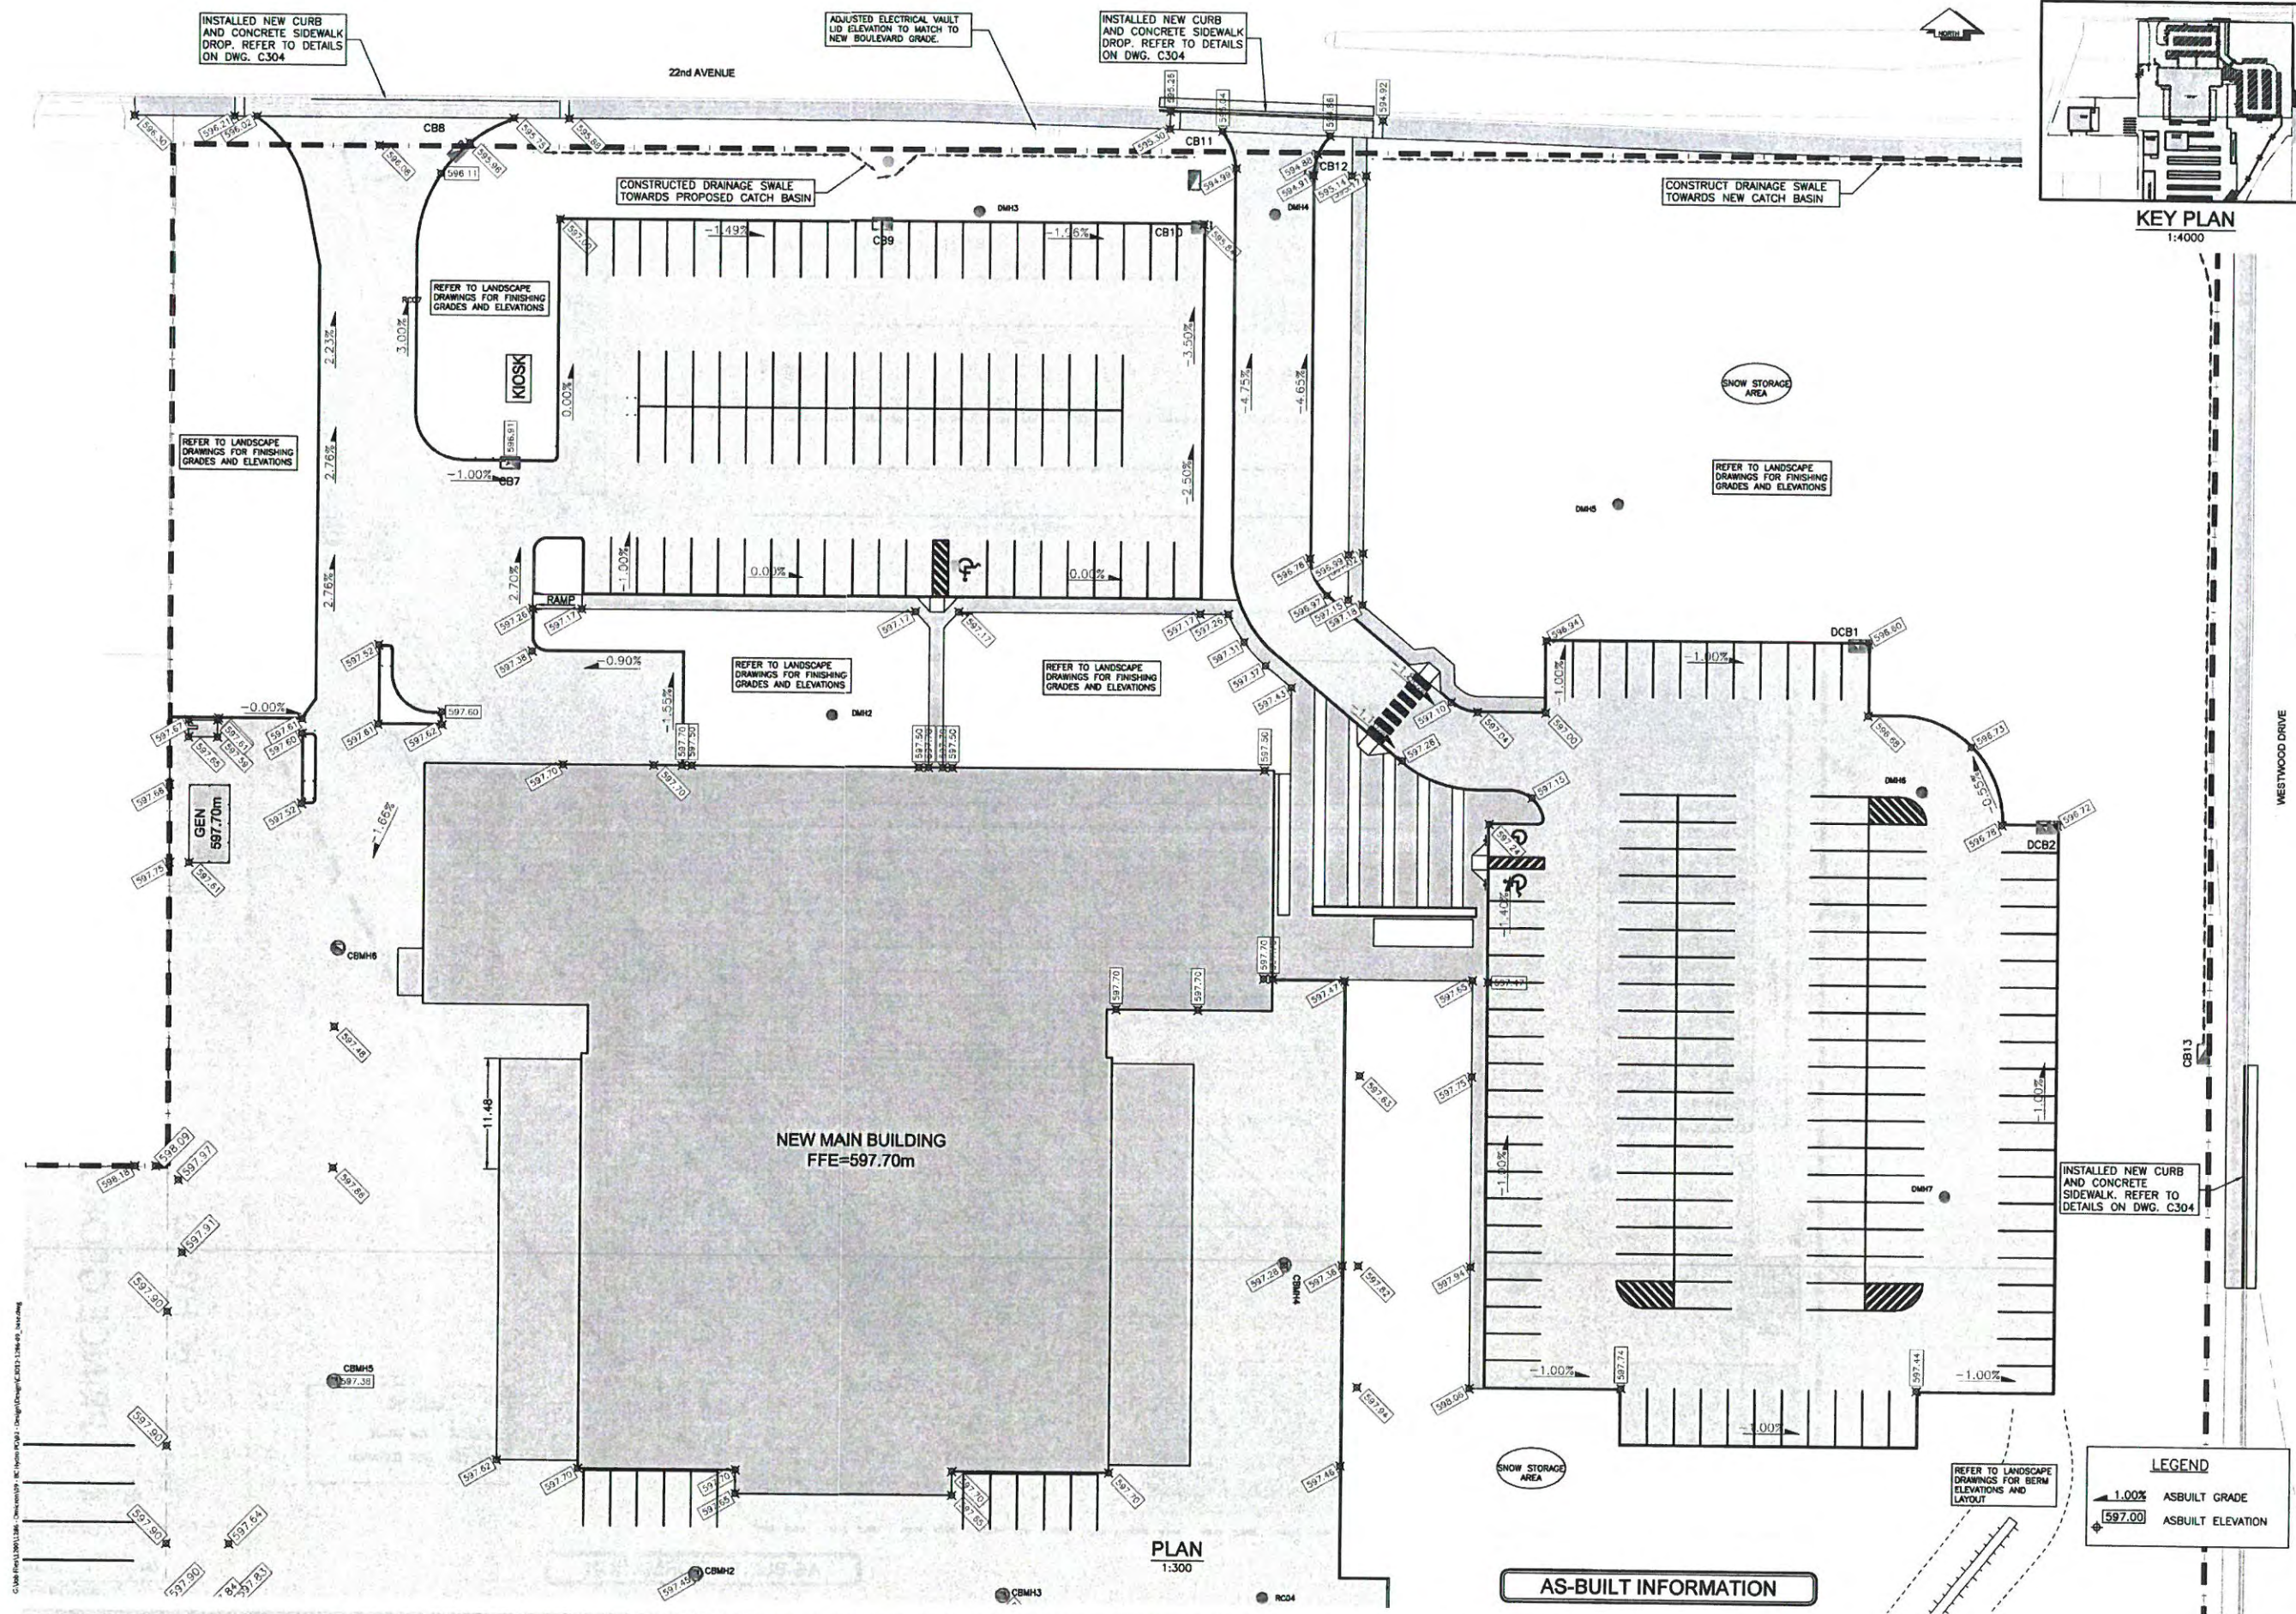

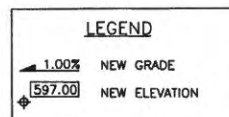

AS-BUILT INFORMATION

1. The first step is to identify the key components of the system. This involves understanding the hardware, software, and data involved.

C005b
eDoc 371058

The City of Prince George does not represent or guarantee that the information contained in this document is accurate or reliable, and any person who relies on this information in this document does so at their own risk.

BC HYDRO

PRINCE GEORGE

PRINCE GEORGE BC

FEB 29 2011

Primary:	JPA	2nd/3rd	TAF
Residual:	TAF	1st/2nd	TAF
Project Number:	1286-09-02		

C005b