
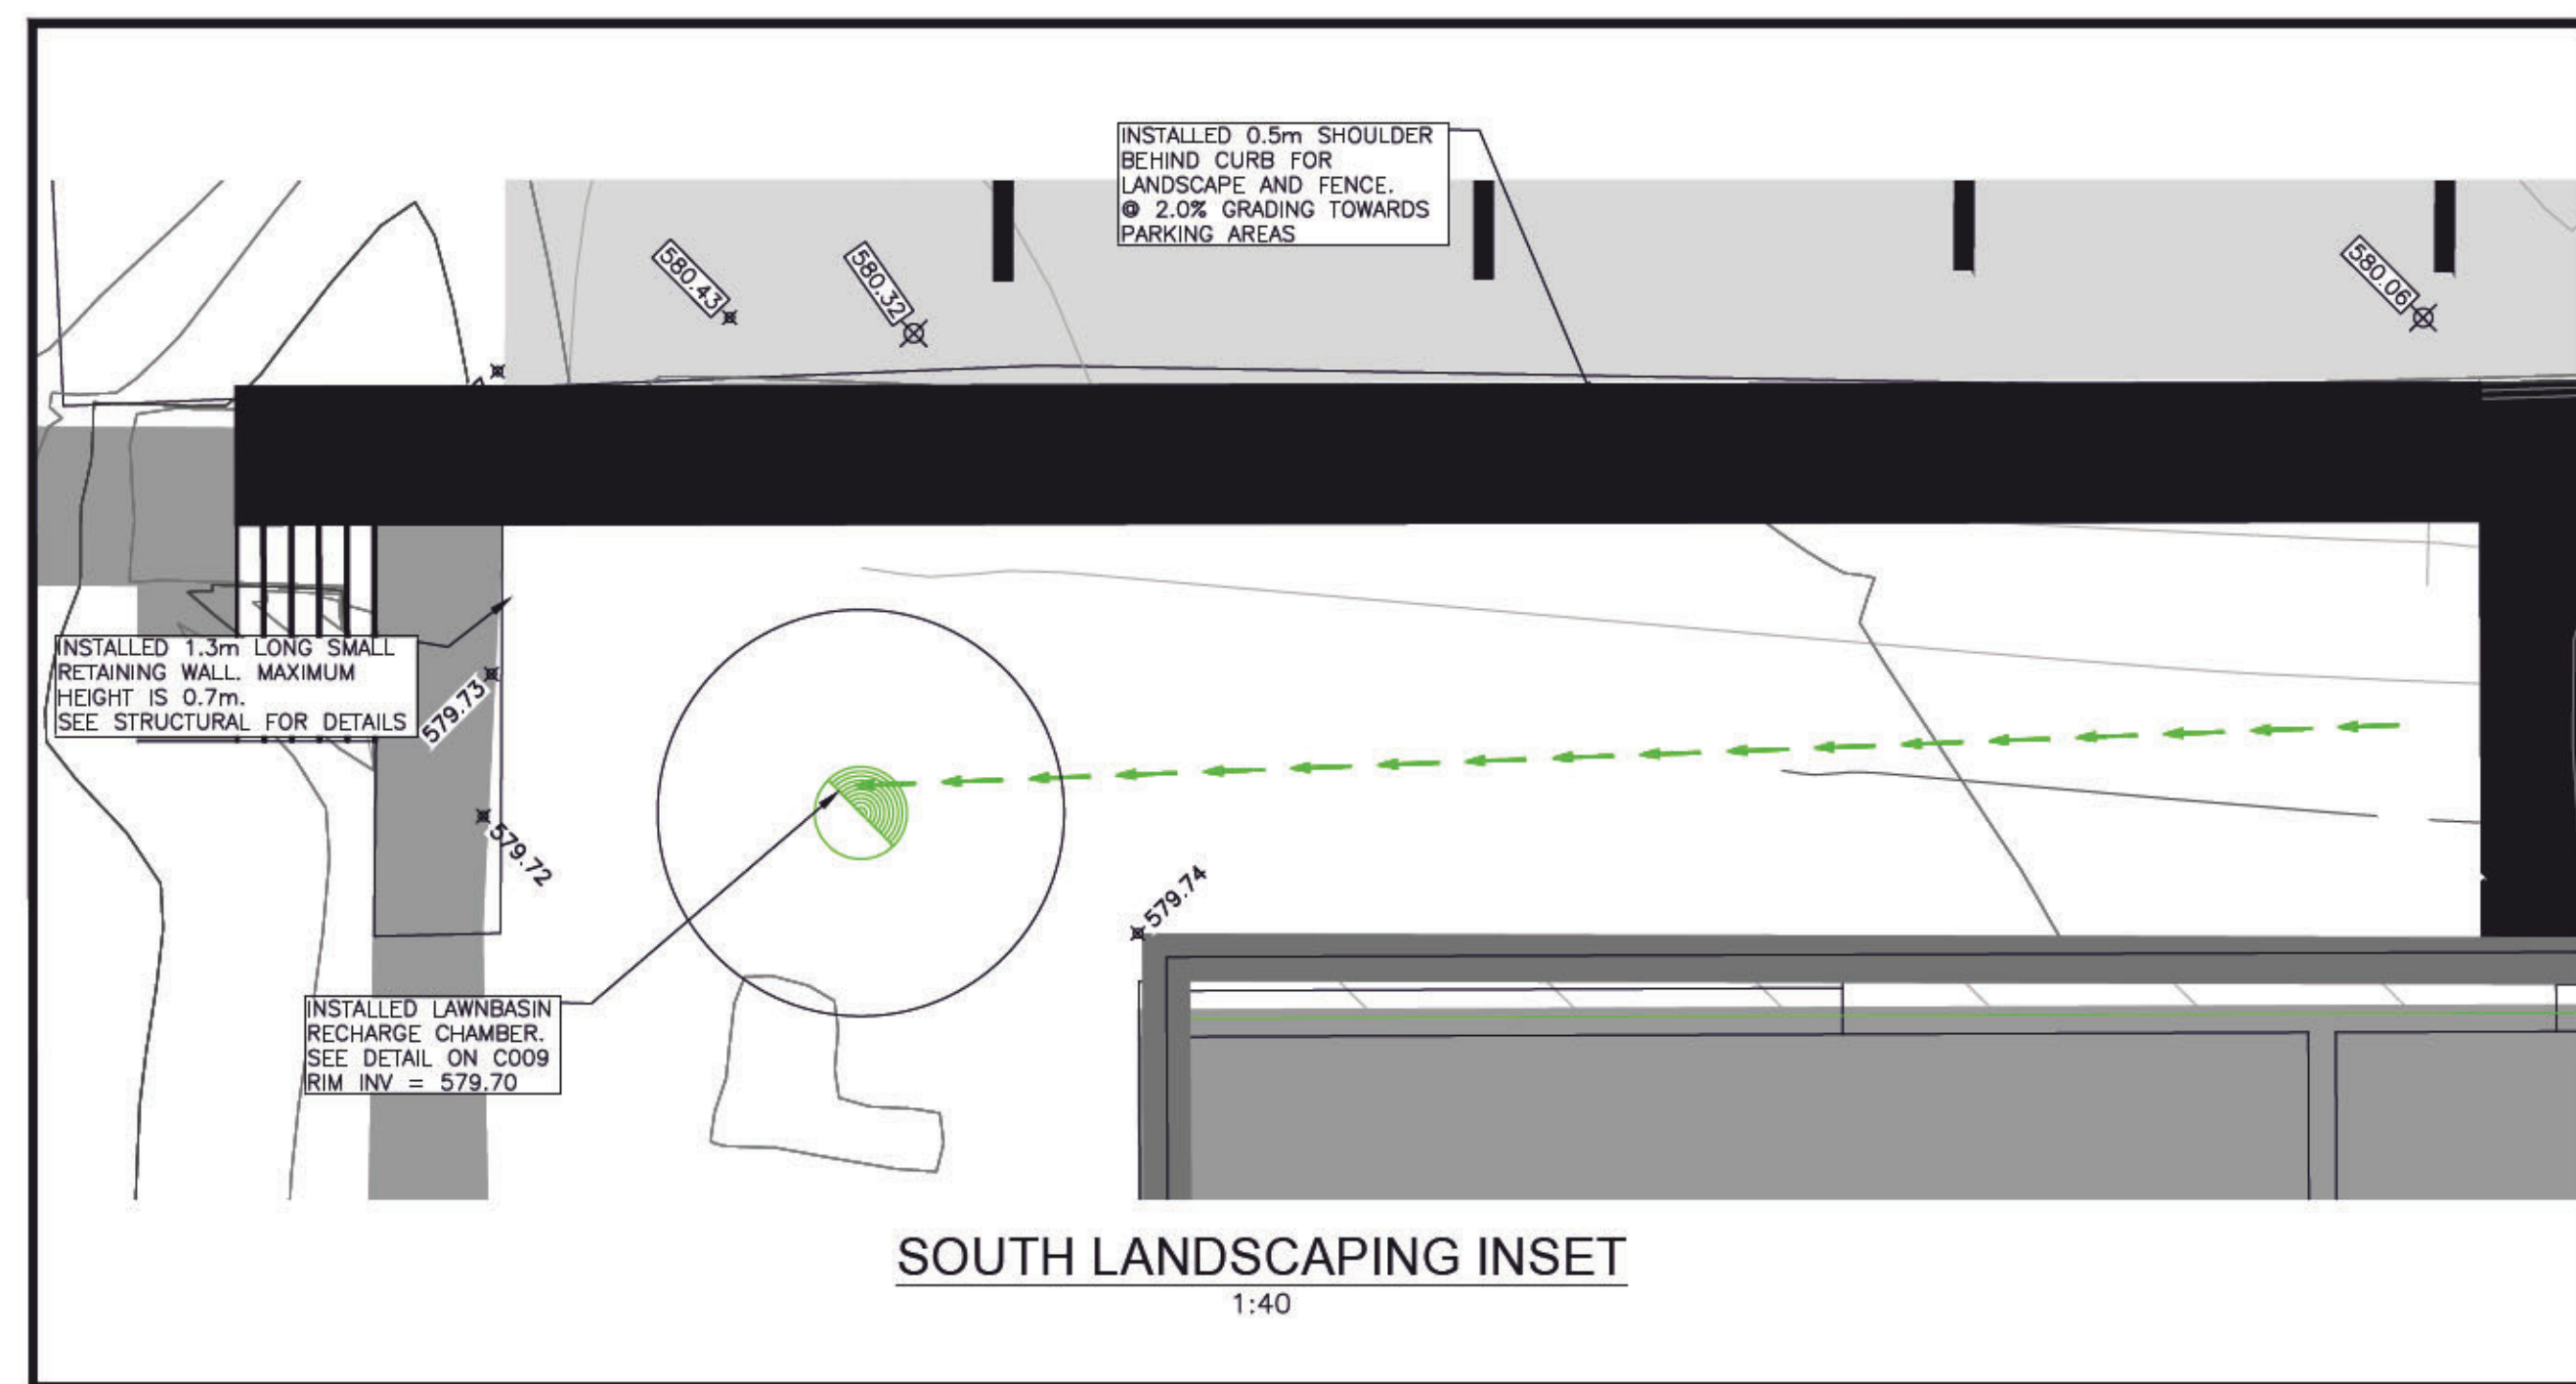


G:\Job Files\1803\1803 - PRD\03 - Retaining Wall\04 - Record Drawing\04\03-1803-03_R01_Base.dwg

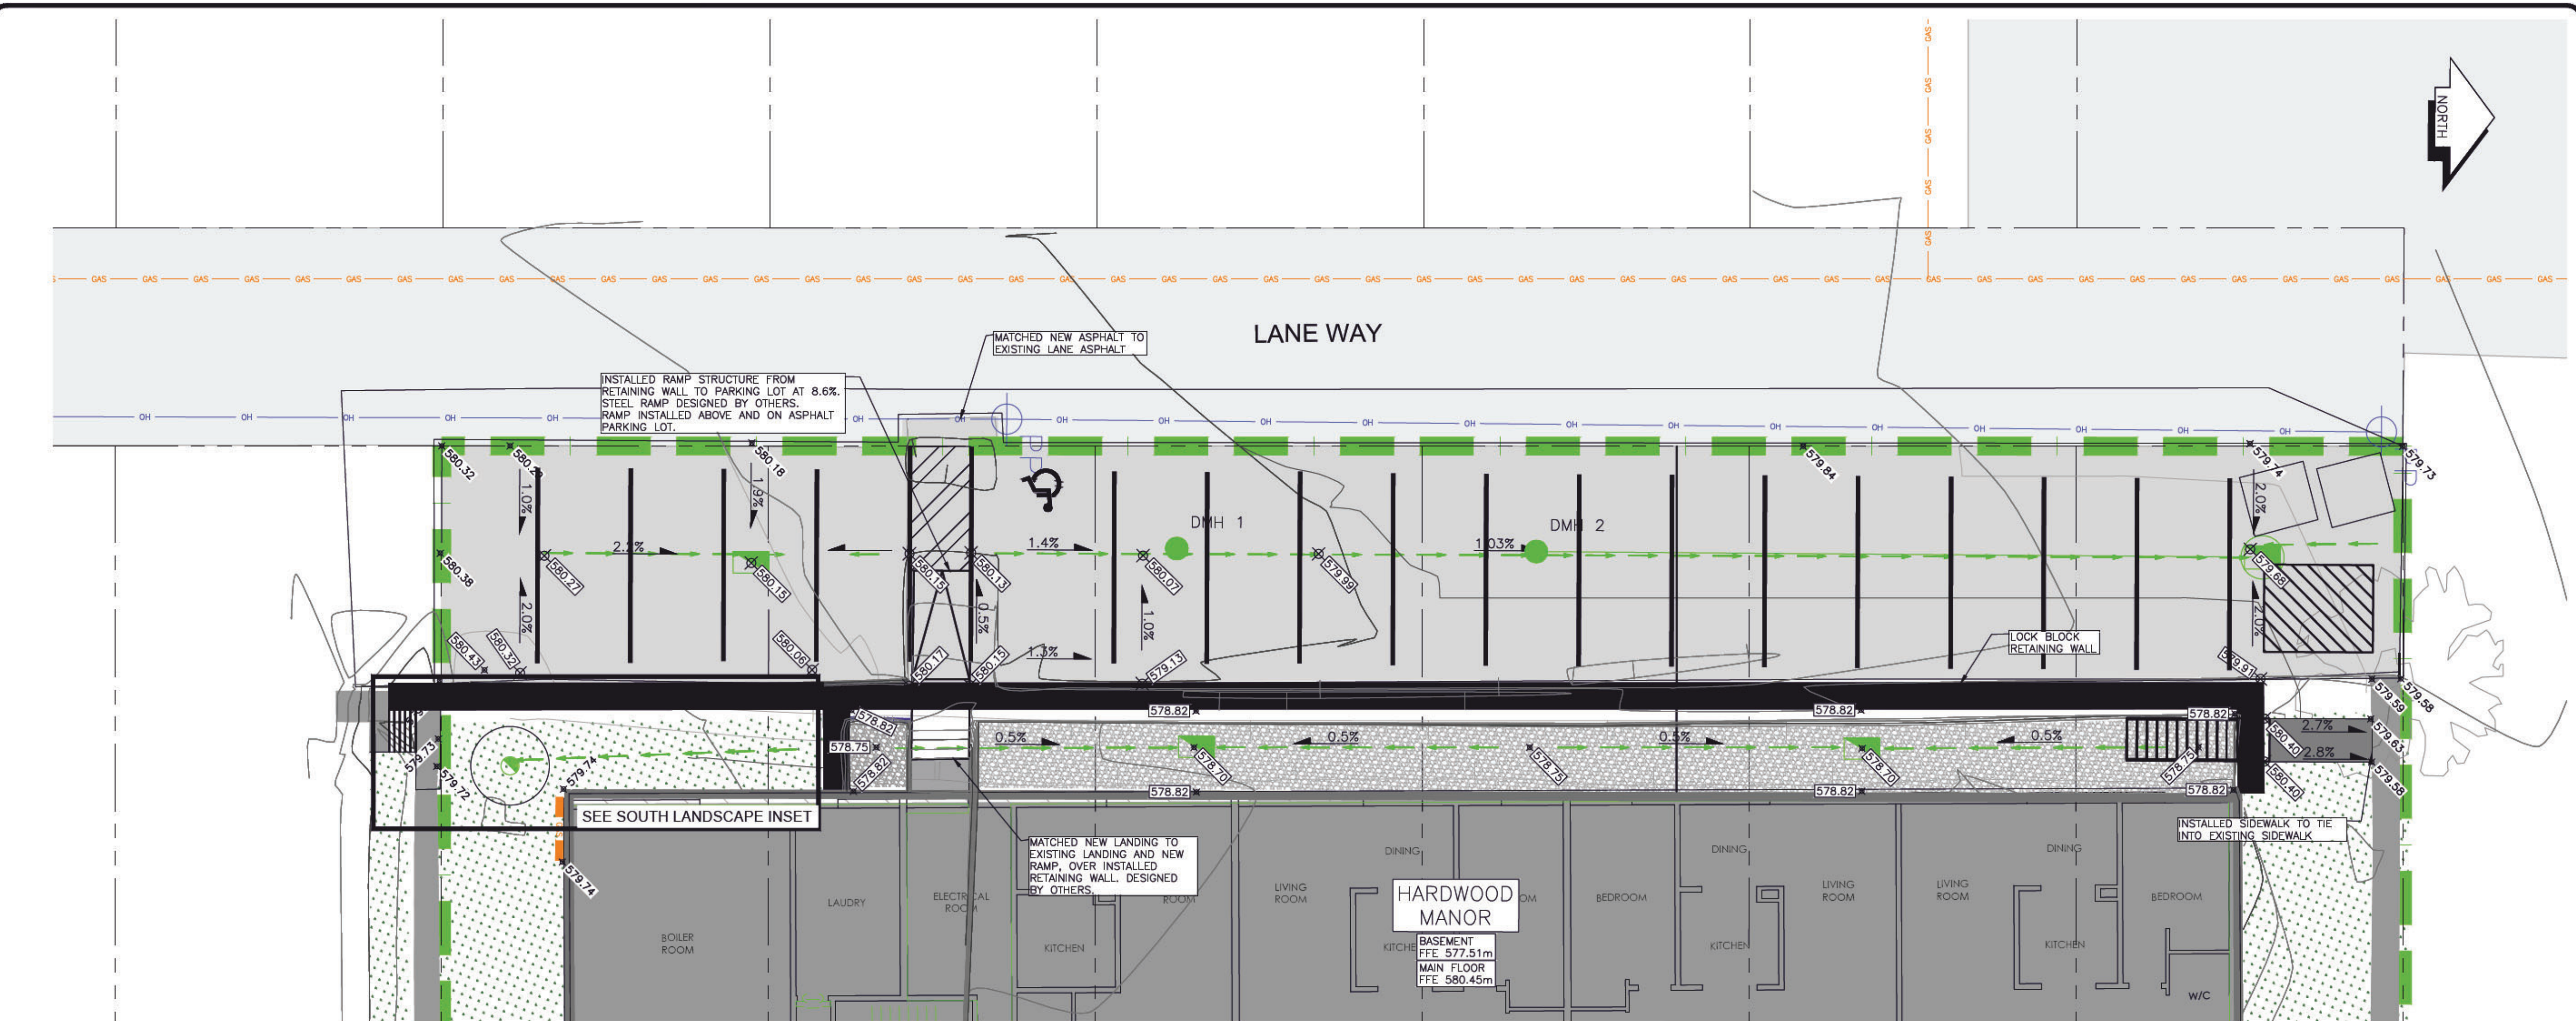

City of Prince George

This information has been provided subject to the *Federal Copyright Act* and in accordance with the Provincial *Freedom of Information and Protection of Privacy Act*.

The City of Prince George does not represent or guarantee that the information contained in this document is accurate or reliable, and any person who relies on this information in this document does so at their own risk.

LEGEND

EXISTING

- EX. TEST PIT & DRILL HOLE
- EX. BENCHMARK & SURVEY HUBS
- EX. IP'S & ISM'S
- EX. LEGAL LINE
- EX. LEGAL R.O.W. & EASEMENT
- EX. SANITARY & MANHOLE
- EX. SANITARY FORCE MAIN
- EX. STORM & MANHOLE
- EX. SINGLE & DOUBLE CATCHBASIN w/ CB LEADS
- EX. CATCHBASIN MANHOLE
- EX. CULVERT
- EX. FIRE HYDRANT & VALVE ASSEMBLY
- EX. WATERMAIN & VALVE
- EX. BLOW-OFF ASSEMBLY
- EX. CURB STOP
- EX. ROAD & SIDEWALK
- EX. ROAD SIGN(S)
- EX. SHOULDER
- EX. TOP OF SLOPE
- EX. TOE OF SLOPE
- EX. DITCH or SWALE
- EX. FENCE
- EX. OVERHEAD LINES
- EX. UNDERGROUND LINES
- EX. POWER POLE & ANCHOR
- EX. GAS MAIN

AS BUILT

- AB. LEGAL LINE
- AB. LEGAL R.O.W. & EASEMENT
- AB. SANITARY & MANHOLE
- AB. STORM & MANHOLE
- AB. SINGLE & DOUBLE CATCHBASIN w/ CB LEADS
- AB. CATCHBASIN MANHOLE
- AB. CULVERT
- AB. DITCH or SWALE
- AB. FIRE HYDRANT & VALVE ASSEMBLY
- AB. WATERMAIN & VALVE
- AB. GRAVEL SHOULDER
- AB. ASPHALT
- AB. CURB & SIDEWALK
- AB. ROAD SIGN(S)

NO.	DATE (D/M/Y)	REVISION	BY
4	7/25	RECORD DRAWING	KP
3	24/4/25	REV GRADING BLD & WALL	KP
2	18/12/24	ISSUED FOR CONSTRUCTION	KP
1	19/11/24	ISSUED FOR BLDG PERMIT	KP

RECORD DRAWING

L&M
ENGINEERING LIMITED

BC HOUSING


CONSULTANTS PROJECT No.: 1803-02	
DRAWN: KS	
CHECKED: TAF	
ENGINEER: TAF	
DATE: 05/08/2024	
SCALE: FULL 1:100	
SCALE: HALF 1:200	

PRD CONSTRUCTION LTD.
B.C. HOUSING
HARDWOOD MANOR
1575 QUEENSWAY
PRINCE GEORGE, B.C.
GRADING PLAN


DRAWING No.

C007



0 3 6 Meters

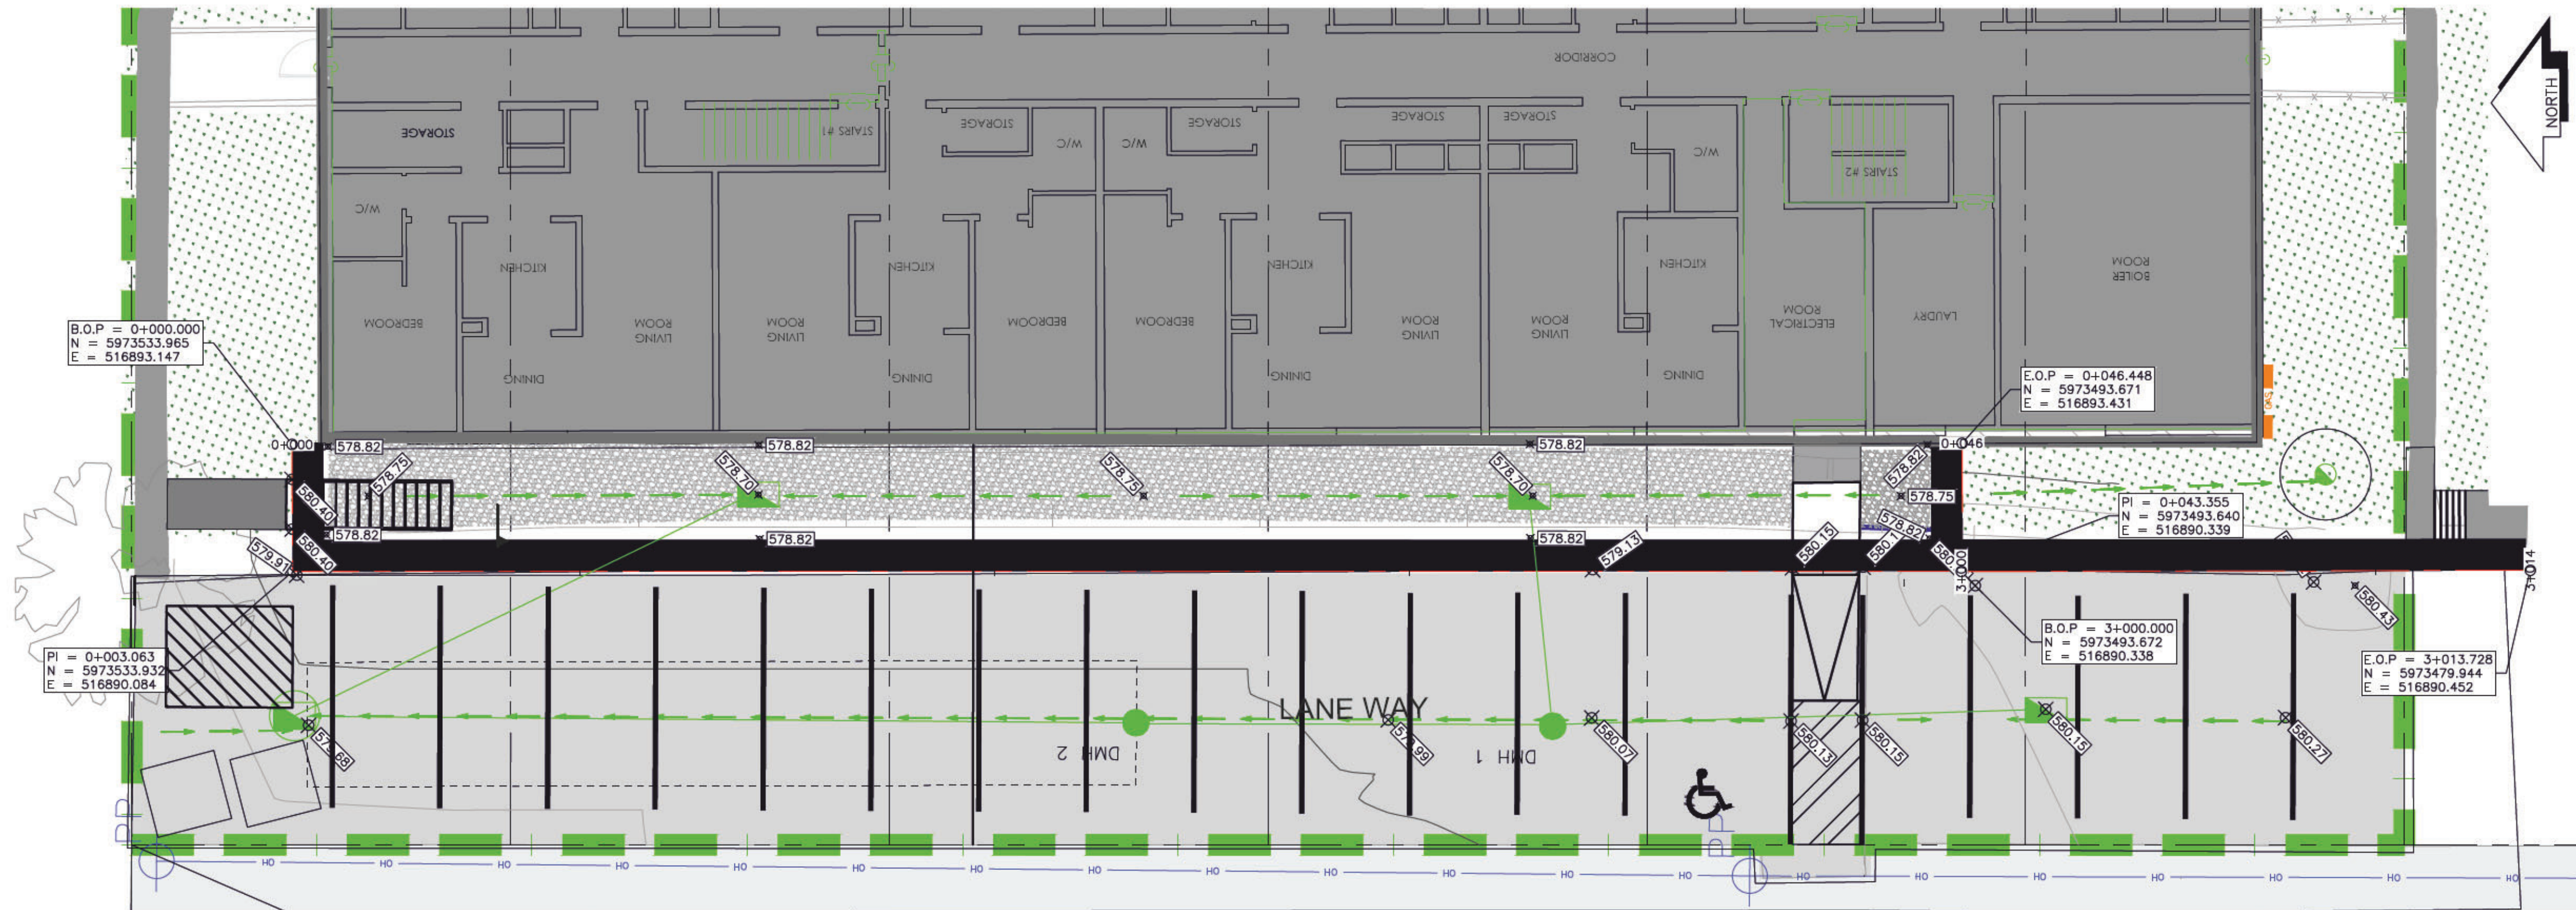

BACK OF RETAINING WALL

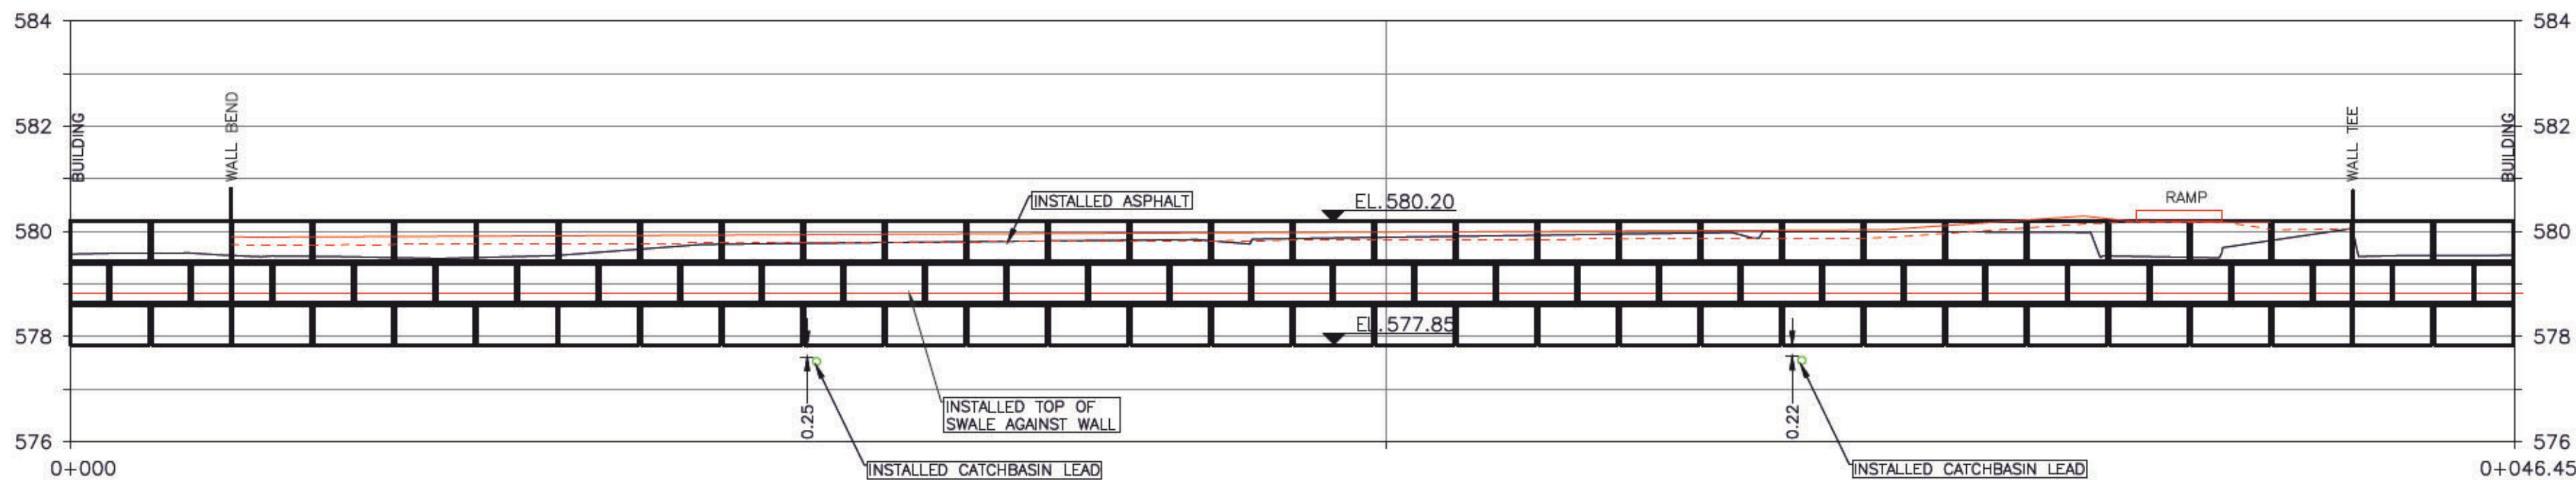

WALL EXTENSION

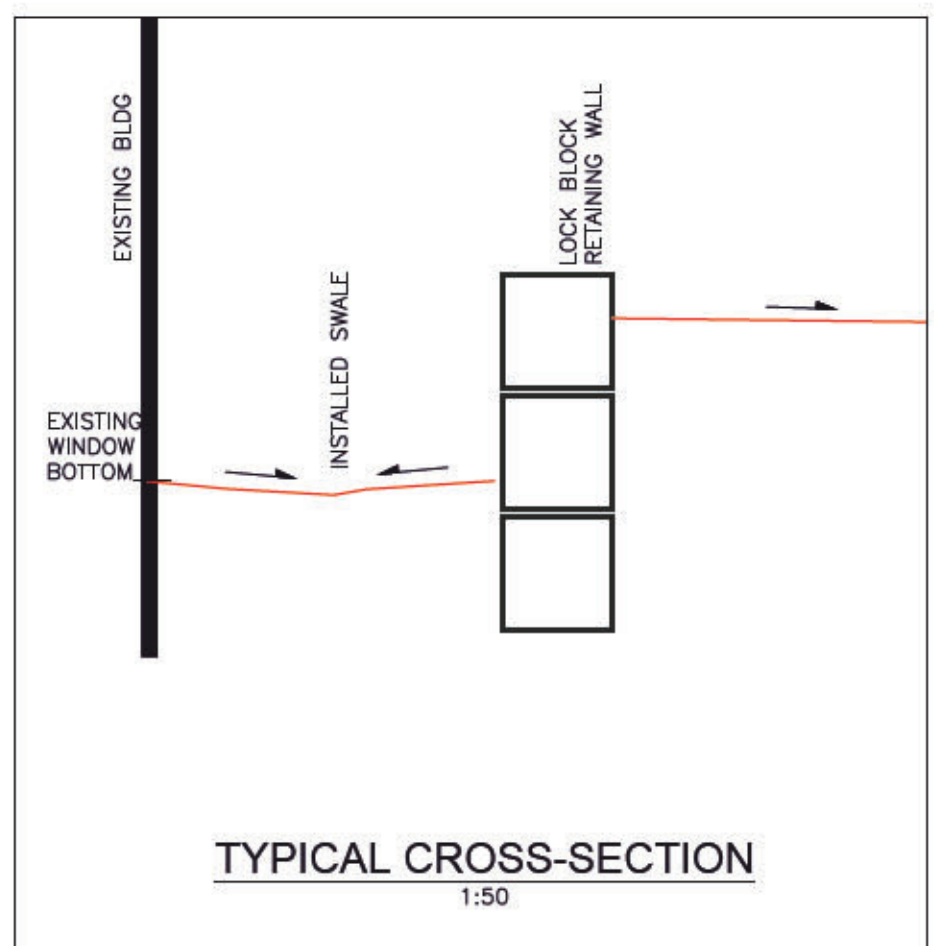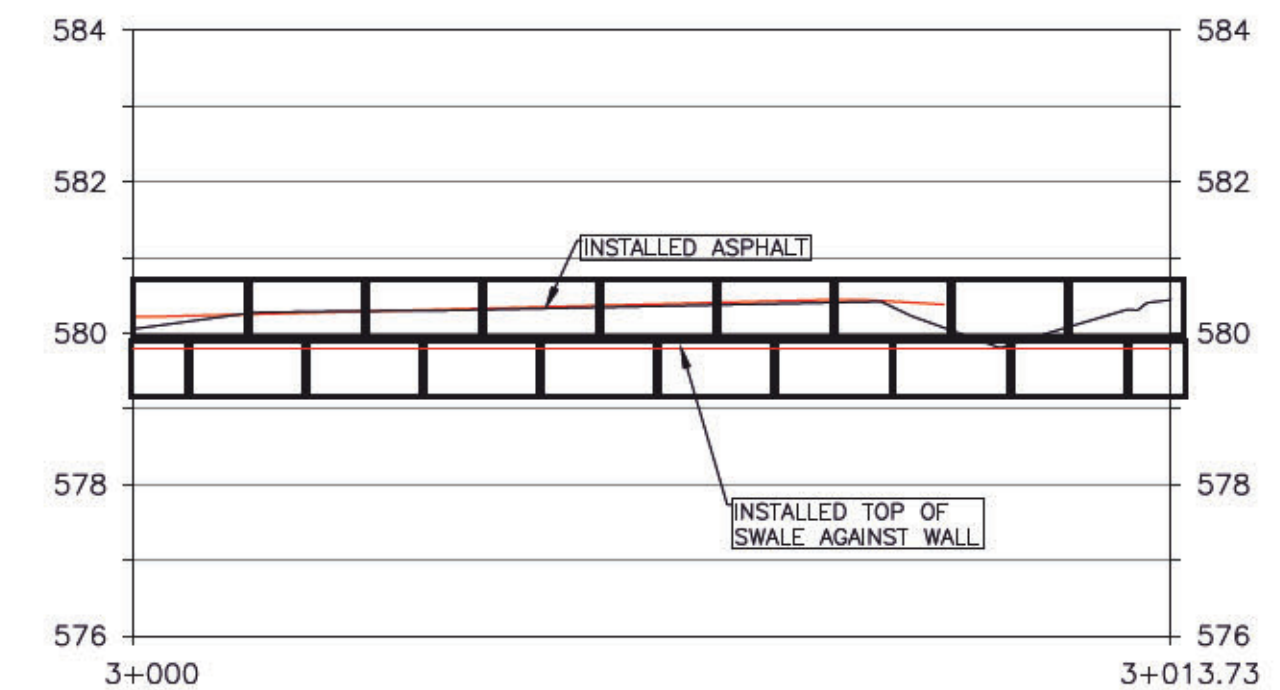

City of Prince George

This information has been provided subject to the *Federal Copyright Act* and in accordance with the *Provincial Freedom of Information and Protection of Privacy Act*.

The City of Prince George does not represent or guarantee that the information contained in this document is accurate or reliable, and any person who relies on this information in this document does so at their own risk.

LEGEND

EXISTING

- EX. TEST PIT & DRILL HOLE
- EX. BENCHMARK & SURVEY HUBS
- EX. IP'S & ISM'S
- EX. LEGAL LINE
- EX. LEGAL R.O.W. & EASEMENT
- EX. SANITARY & MANHOLE
- EX. SANITARY FORCE MAIN
- EX. STORM & MANHOLE
- EX. SINGLE & DOUBLE CATCHBASIN w/ CB LEADS
- EX. CATCHBASIN MANHOLE
- EX. CULVERT
- EX. FIRE HYDRANT & VALVE ASSEMBLY
- EX. WATERMAIN & VALVE
- EX. BLOW-OFF ASSEMBLY
- EX. CURB STOP
- EX. ROAD & SIDEWALK
- EX. ROAD SIGN(S)
- EX. SHOULDER
- EX. TOP OF SLOPE
- EX. TOE OF SLOPE
- EX. DITCH or SWALE
- EX. FENCE
- EX. OVERHEAD LINES
- EX. UNDERGROUND LINES
- EX. POWER POLE & ANCHOR
- EX. GAS MAIN

AS BUILT

- AB. LEGAL LINE
- AB. LEGAL R.O.W. & EASEMENT
- AB. SANITARY & MANHOLE
- AB. STORM & MANHOLE
- AB. SINGLE & DOUBLE CATCHBASIN w/ CB LEADS
- AB. CATCHBASIN MANHOLE
- AB. CULVERT
- AB. DITCH or SWALE
- AB. FIRE HYDRANT & VALVE ASSEMBLY
- AB. WATERMAIN & VALVE
- AB. GRAVEL SHOULDER
- AB. ASPHALT
- AB. CURB & SIDEWALK
- AB. ROAD SIGN(S)

NO.	DATE (D/M/Y)	REVISION	BY
4	7/25	RECORD DRAWING	KP
3	24/4/25	REV GRADING BLD & WALL	KP
2	18/12/24	ISSUED FOR CONSTRUCTION	KP
1	19/11/24	ISSUED FOR BLDG PERMIT	KP

RECORD DRAWING

L&M
ENGINEERING LIMITED

BC HOUSING

CONSULTANTS PROJECT No.: 1803-02	
DRAWN: KS	
CHECKED: TAF	
ENGINEER: TAF	
DATE: 05/08/2024	
SCALES: FULL 1:100 HALF 1:200	

PRD CONSTRUCTION LTD.
B.C. HOUSING
HARDWOOD MANOR
1575 QUEENSWAY
RETAINING WALL
PLAN/PROFILE

DRAWING No.

C008

0 3 6 Meters