

LEGEND

EXISTING

- EX. LEGAL LINE
- EX. SANITARY MAIN
- EX. CULVERT
- EX. FIRE HYDRANT & VALVE ASSEMBLY
- EX. WATER VALVE
- EX. CURB STOP
- EX. ROAD & SIDEWALK
- EX. TOP OF SLOPE
- EX. TOE OF SLOPE
- EX. DITCH or SWALE
- EX. FENCE
- EX. OVERHEAD LINES
- EX. POWER POLE & ANCHOR

PROPOSED

- PR. STORM MANHOLE
- PR. CATCHBASIN MANHOLE
- PR. DITCH or SWALE
- PR. ASPHALT

NO.	DATE (D/M/Y)	REVISION	BY
4	18/1/24	RECORD DRAWING	JPA
3	10/5/21	ADDED EASTERN ST. PROFILE STA.	JPA
2	3/5/21	ISSUED FOR BUILDING PERMIT	JPA
1	15/3/21	ISSUED FOR BUILDING PERMIT	JPA
0	19/1/21	ISSUED FOR DEVELOPMENT PERMIT	JPA

RECORD DRAWING




CONSULTANTS PROJECT No.: 1567-04

DRAWN: JPA	
CHECKED: TAF	
ENGINEER: TAF	
DATE: 18/10/2020	
PERMIT TO PRACTICE NO 1002375	

SCALES: HALF 1:300
SCALES: FULL 1:150

1033 EASTERN STREET
GRADING PLAN

DRAWING No.
C003

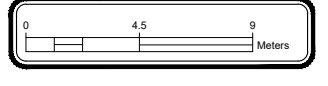

The City of Prince George does not represent or guarantee that the information contained in this document is accurate or reliable, and any person who relies on this information in this document does so at their own risk.

City of Prince George
This information has been provided subject to the Federal Copyright Act and in accordance with the Provincial Freedom of Information and Protection of Privacy Act

THE SEAL AND SIGNATURE OF THE UNDERSIGNED ON THIS DRAWING CERTIFIES THAT THE DESIGN INFORMATION CONTAINED IN THESE DRAWINGS ACCURATELY REFLECTS THE ORIGINAL DESIGN AND THE MATERIAL DESIGN CHANGES MADE DURING CONSTRUCTION, THAT WERE BROUGHT TO THE UNDERSIGNED'S ATTENTION. THESE DRAWINGS ARE INTENDED TO INCORPORATE ADDENDA, CHANGE ORDERS AND OTHER MATERIAL DESIGN CHANGES, BUT NOT NECESSARILY ALL SITE INSTRUCTIONS. THE UNDERSIGNED DOES NOT WARRANT OR GUARANTEE, NOR ACCEPT ANY RESPONSIBILITY FOR THE ACCURACY OR COMPLETENESS OF THE AS-CONSTRUCTED INFORMATION SUPPLIED BY OTHERS CONTAINED IN THESE DRAWINGS, BUT DOES, BY SEALING AND SIGNING, CERTIFY THAT THE AS CONSTRUCTED INFORMATION, IF ACCURATE AND COMPLETE, PROVIDES AN AS-CONSTRUCTED SYSTEM WHICH SUBSTANTIALLY COMPLIES IN ALL MATERIAL RESPECTS WITH THE ORIGINAL DESIGN INTENT.

RECORD DRAWING