


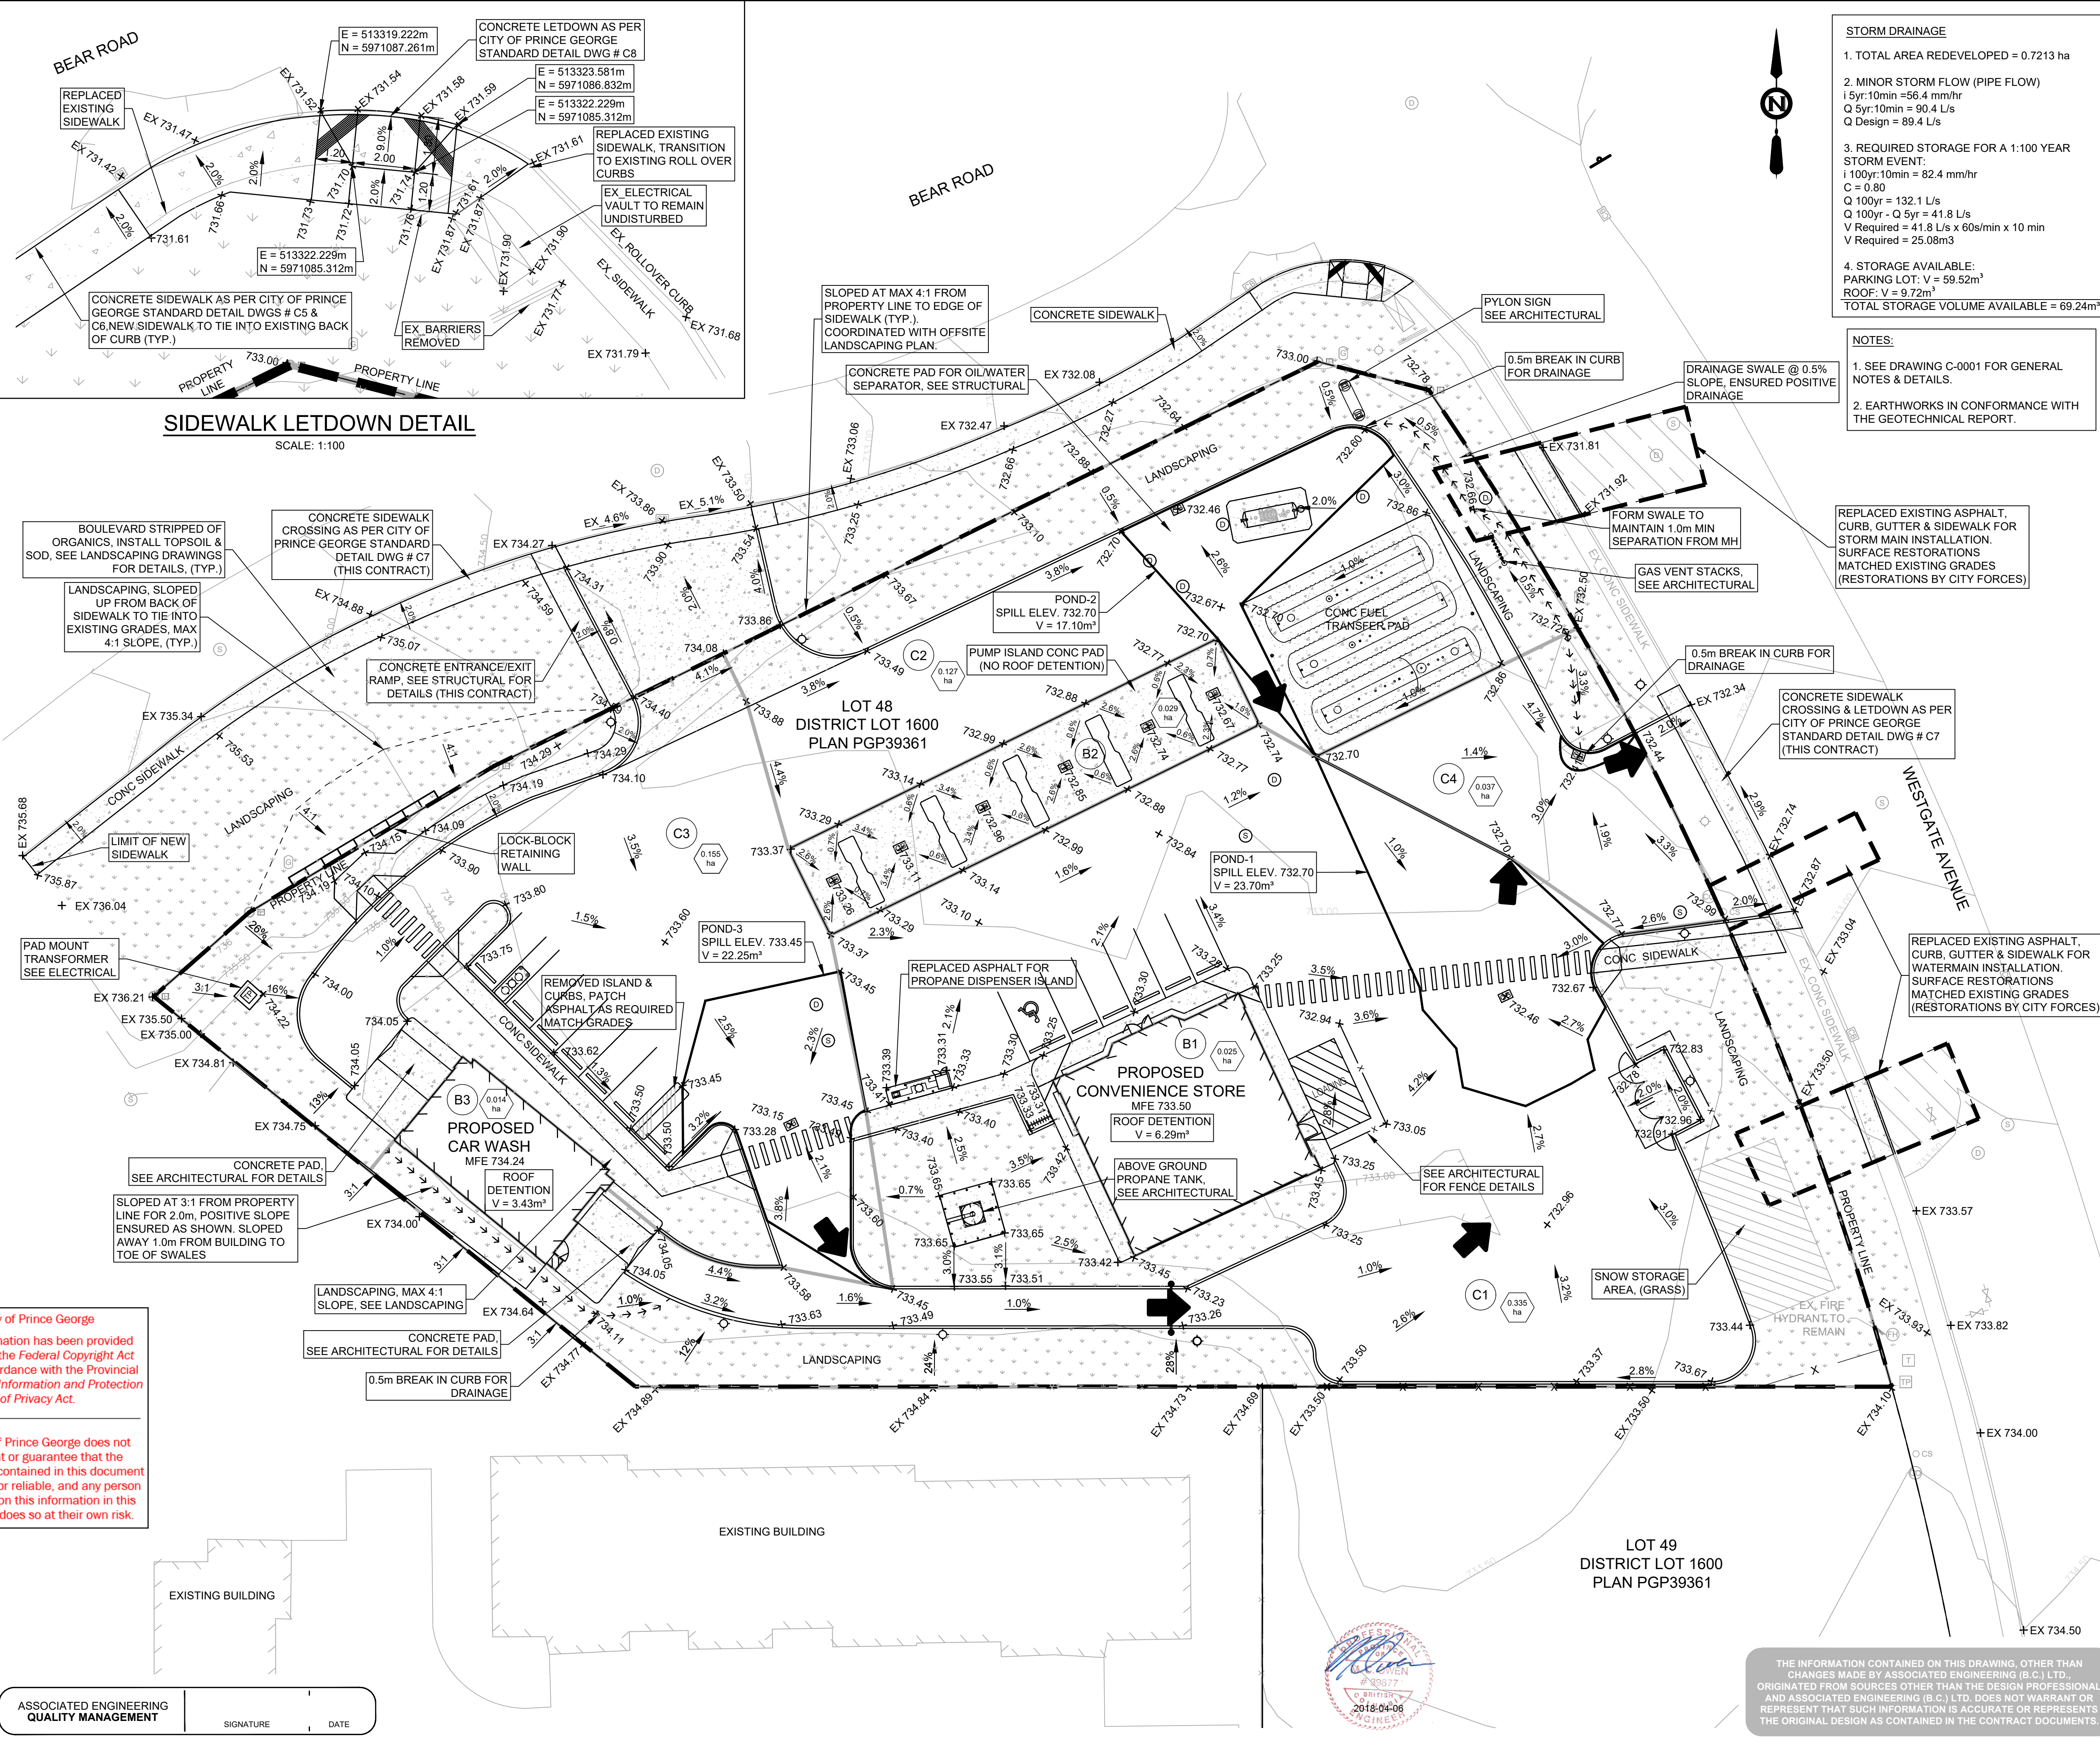

FEDERATED
CO-OPERATIVES
LIMITED
PETROLEUM DEPARTMENT

DIALOG

300, 134 11 Avenue SE, Calgary, AB T2G 0X5
403 245 5501 T 403 229 0504 F

ISSUED FOR:

- 0. 16/02/2017 - ISSUED FOR BP/BID
- 1. 11/04/2017 - ISSUED FOR CONSTRUCTION
- 2. 21/04/2017 - REVISED AS PER CIVIL CCN 1
- 3. 12/05/2017 - RE-ISSUED FOR BP
- 4. 24/05/2017 - RE-ISSUED FOR BP
- 5. 29/05/2017 - REVISED AS PER CCN#2
- 6. 11/08/2017 - REVISED AS PER CSI#1
- 7. 06/04/2018 - RECORD DRAWING



VANDERHOOF & DISTRICTS COOP

NEW GAS BAR FACILITY

6749 WESTGATE AVE, PRINCE GEORGE, BC
LOT 48, DISTRICT LOT 1600, PLAN PGP39361

DRAWN: A.SANGSTER

CHECKED: DM

PLOT DATE: 06/02/2018

SITE GRADING

PLAN

DRAWING No: 2351-00-C-1001

2016-2351

SCALE 1:250