


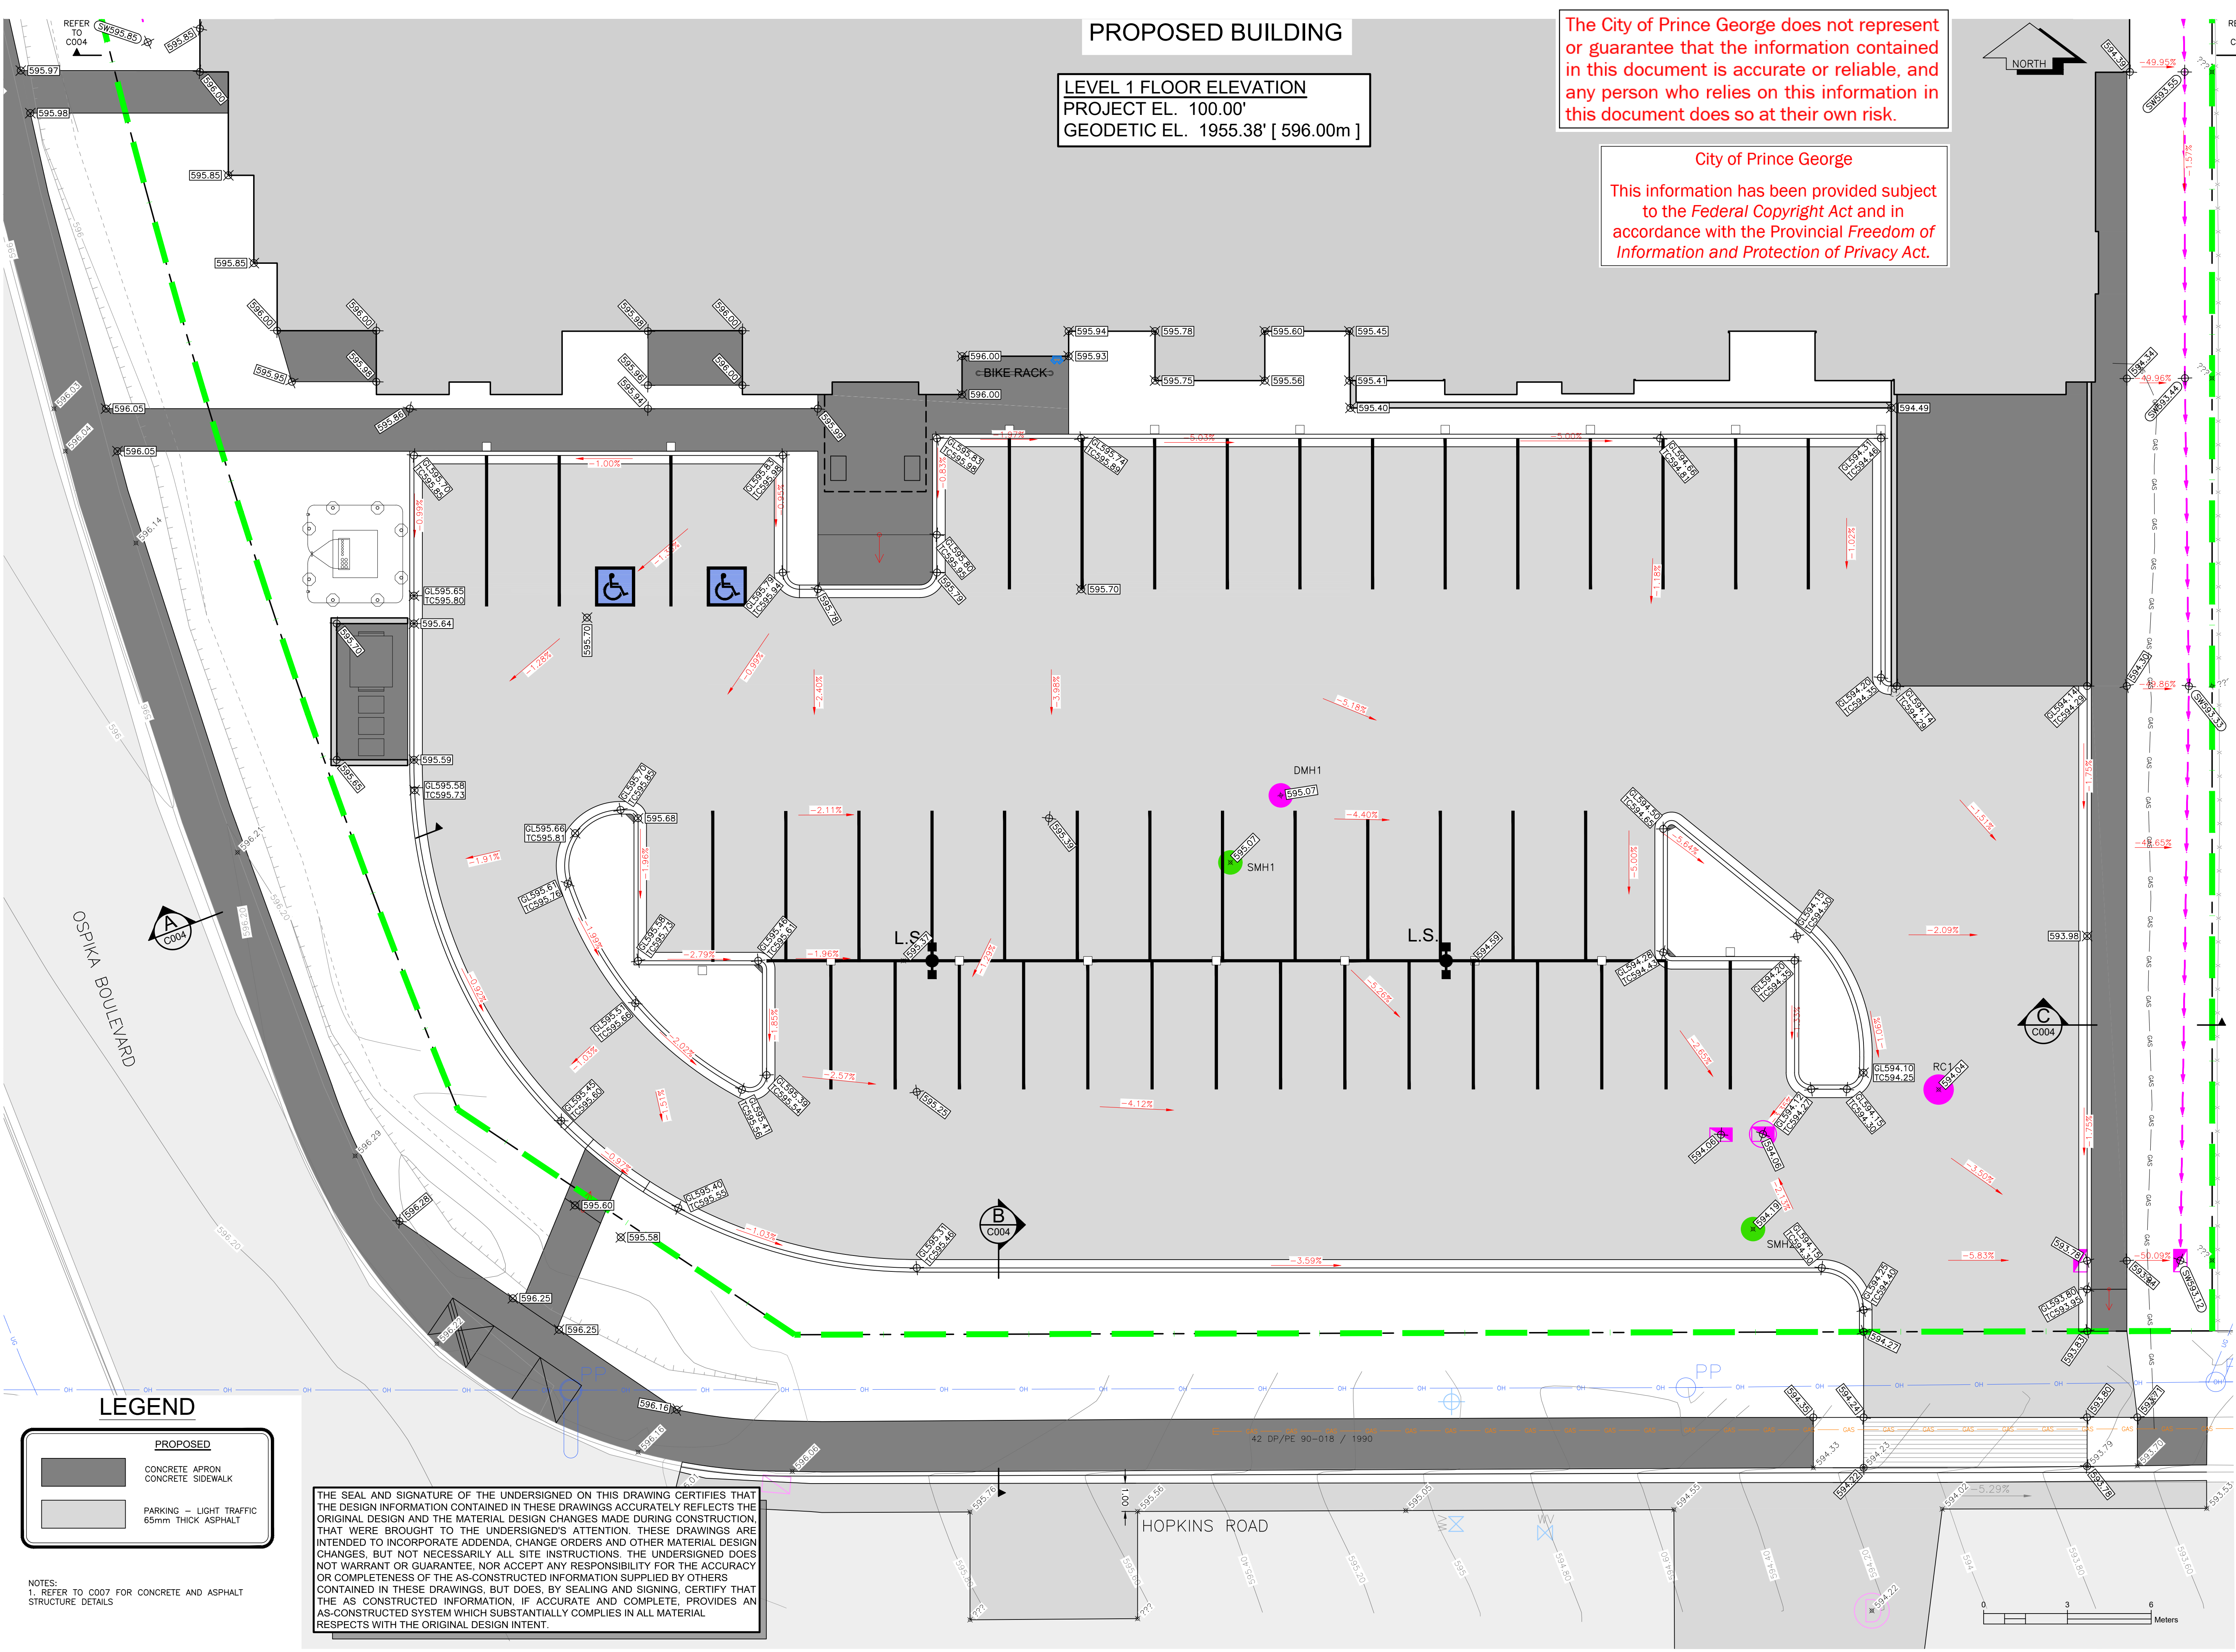

The City of Prince George does not represent or guarantee that the information contained in this document is accurate or reliable, and any person who relies on this information in this document does so at their own risk.

City of Prince George
This information has been provided subject to the *Federal Copyright Act* and in accordance with the *Provincial Freedom of Information and Protection of Privacy Act*.

- 7 23/5/23 RECORD DRAWING
6 22/7/2021 REVISED HOPKINS ROAD ASPHALT
5 7/5/2021 ISSUED FOR CONSTRUCTION
4 27/04/2021 UPDATED AS PER CITY COMMENTS
3 29/03/2021 RE-ISSUE BUILDING PERMIT
2 19/11/2020 ISSUED FOR BUILDING PERMIT
1 26/10/2020 ISSUED FOR REVIEW
No. DATE REVISION

PROJECT TITLE
2918 HOPKINS APARTMENT BUILDING
2918 HOPKINS ROAD
PRINCE GEORGE, BC

© Copyright reserved, this plan and design is and at all times remains the exclusive property of Chernoff Thompson Architects North and cannot be used without the architects consent.
All dimensions on the project must be checked by the contractor.
This drawing must not be used for construction purposes until here counter signed.
Date: _____

PROFESSIONAL ENGINEER
T.A. JELLIESTROM
20194
ENGINEER
PERMIT TO PRACTICE
NO 1002375
2023-05-23







L&M ENGINEERING LIMITED
1210 FOURTH AVENUE
PRINCE GEORGE, B.C.
V2L 3J4
TEL. (250) 562-1977
FAX (250) 562-1967

SHEET TITLE
GRADING PLAN
SHT 1 of 2

PROJECT No. 1482-13
DRAWN JPA
CHECKED TAF
SCALE FULL, 1:100
DATE 31/03/2020
PRINTED 23/5/23

REVISION No.
C003

CHERNOFF THOMPSON ARCHITECTS NORTH
230-177 VICTORIA STREET, PRINCE GEORGE BC V2L 5R8
PHONE: (250) 564-7285 FAX: (250) 564-7286
ADMIN@CHTARCHITECTS.NORTH.CA WWW.CHTARCHITECTS.NORTH.CA

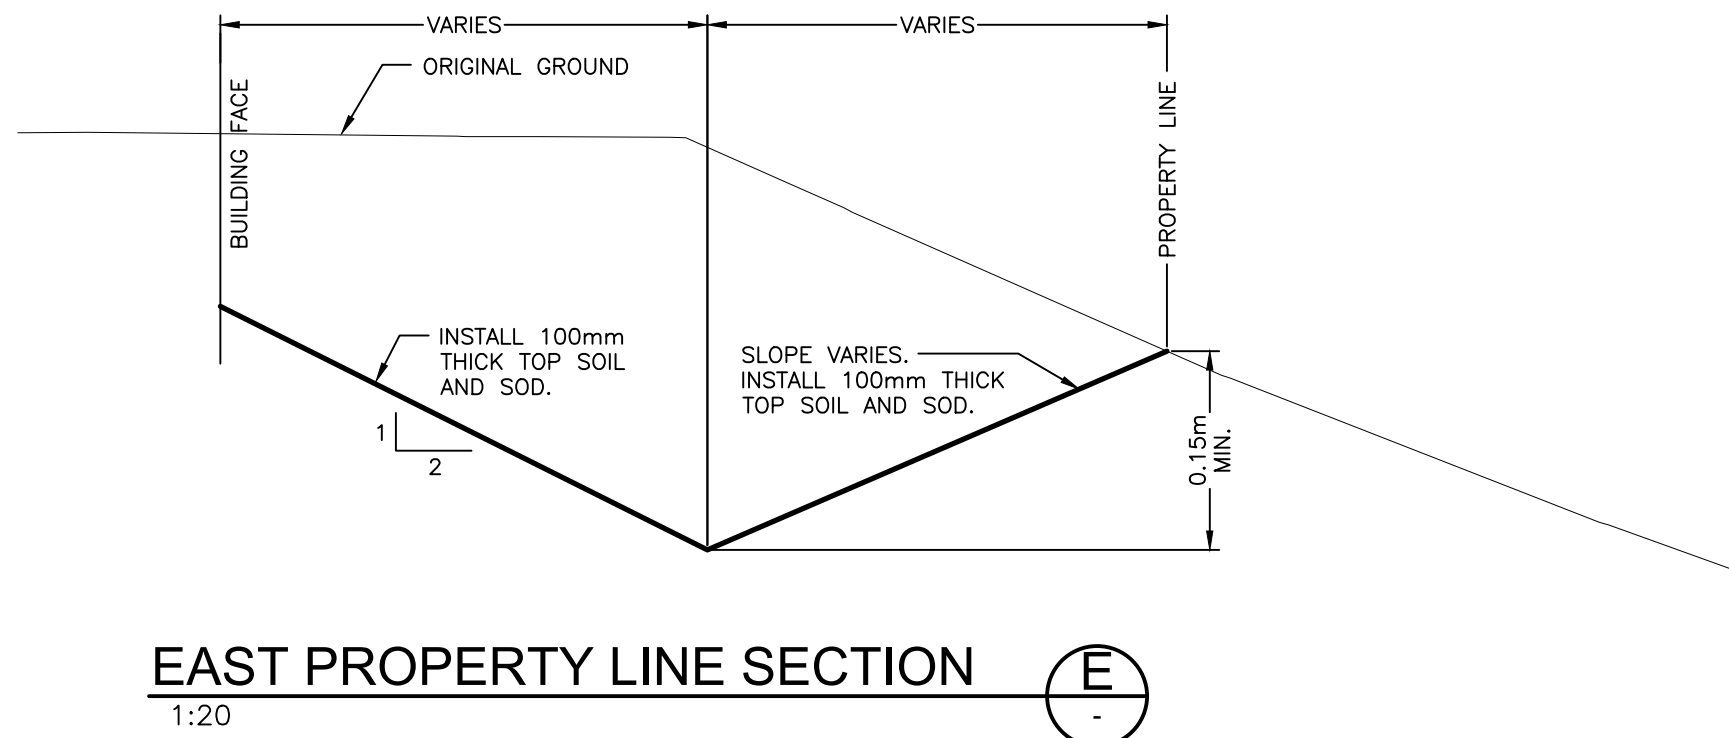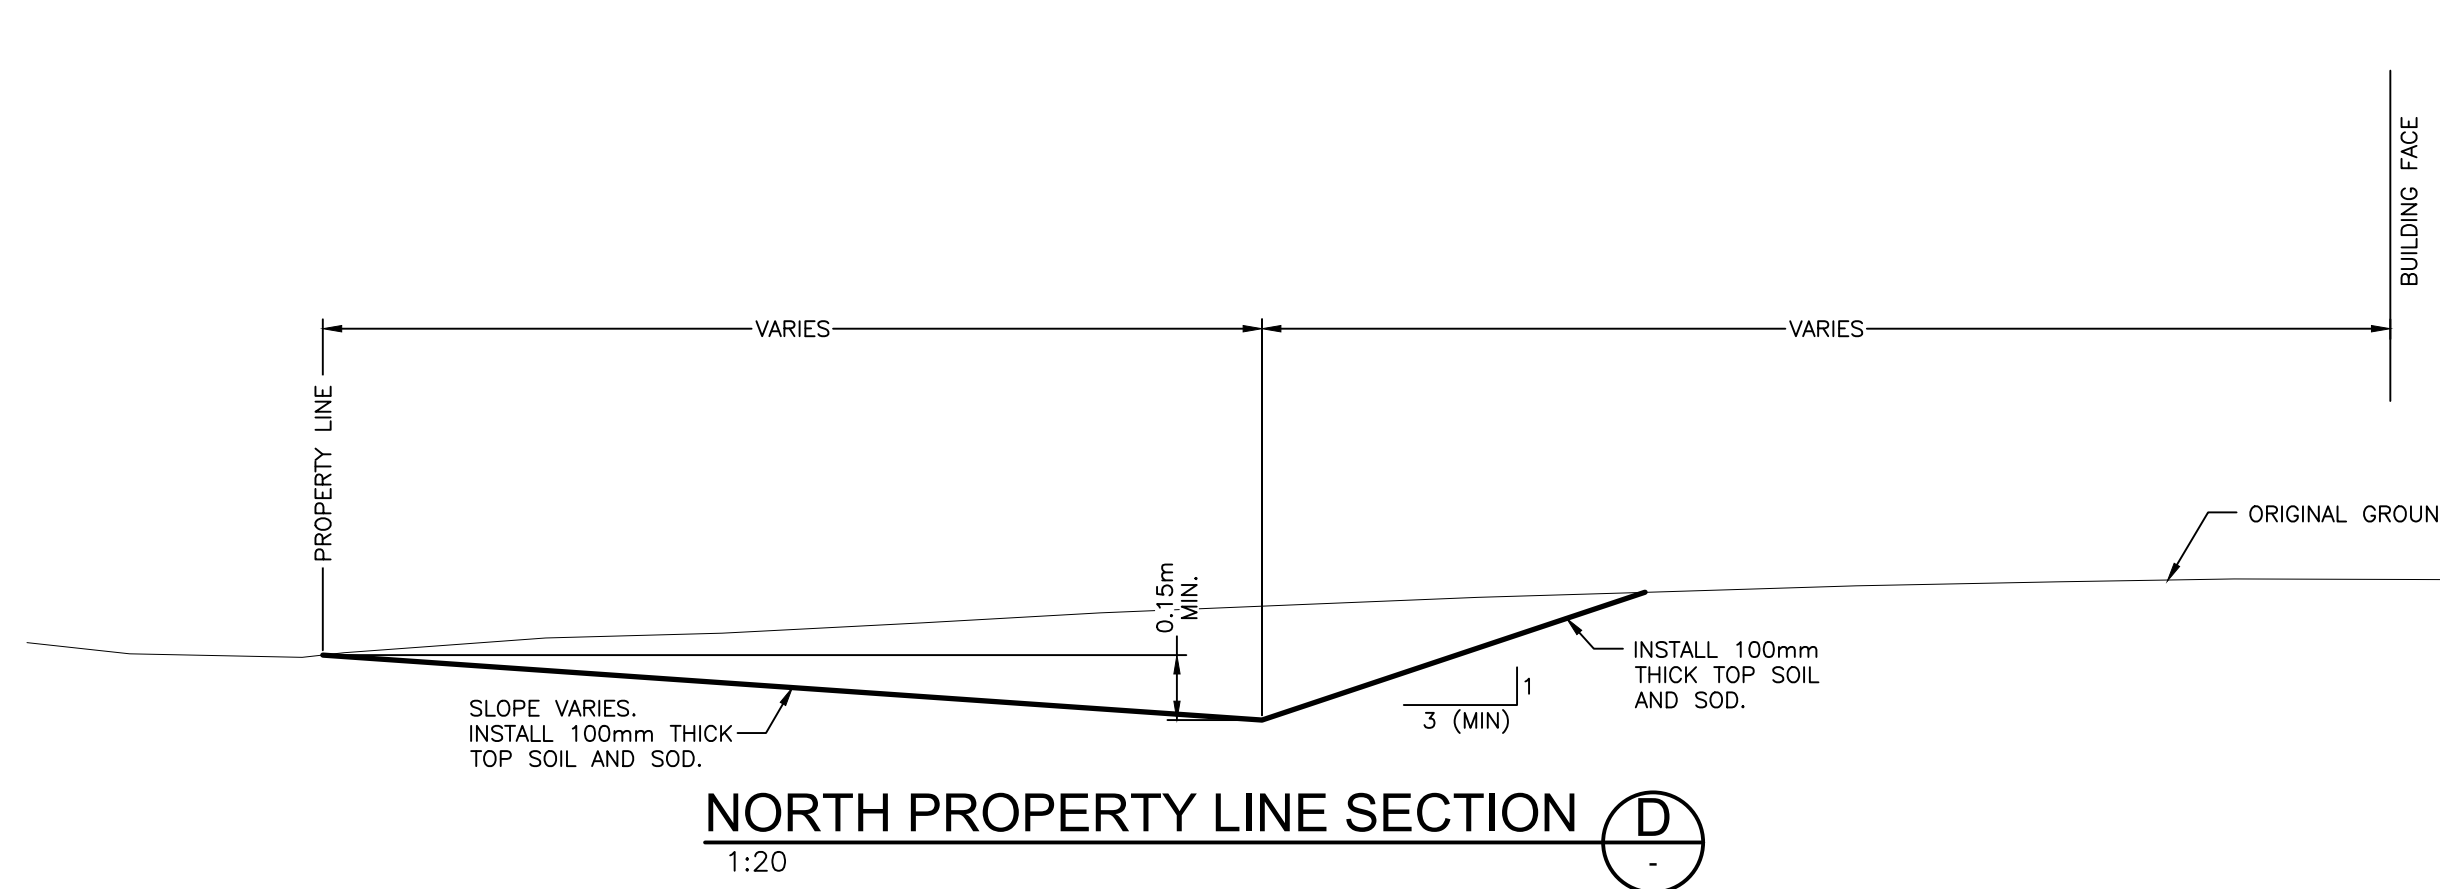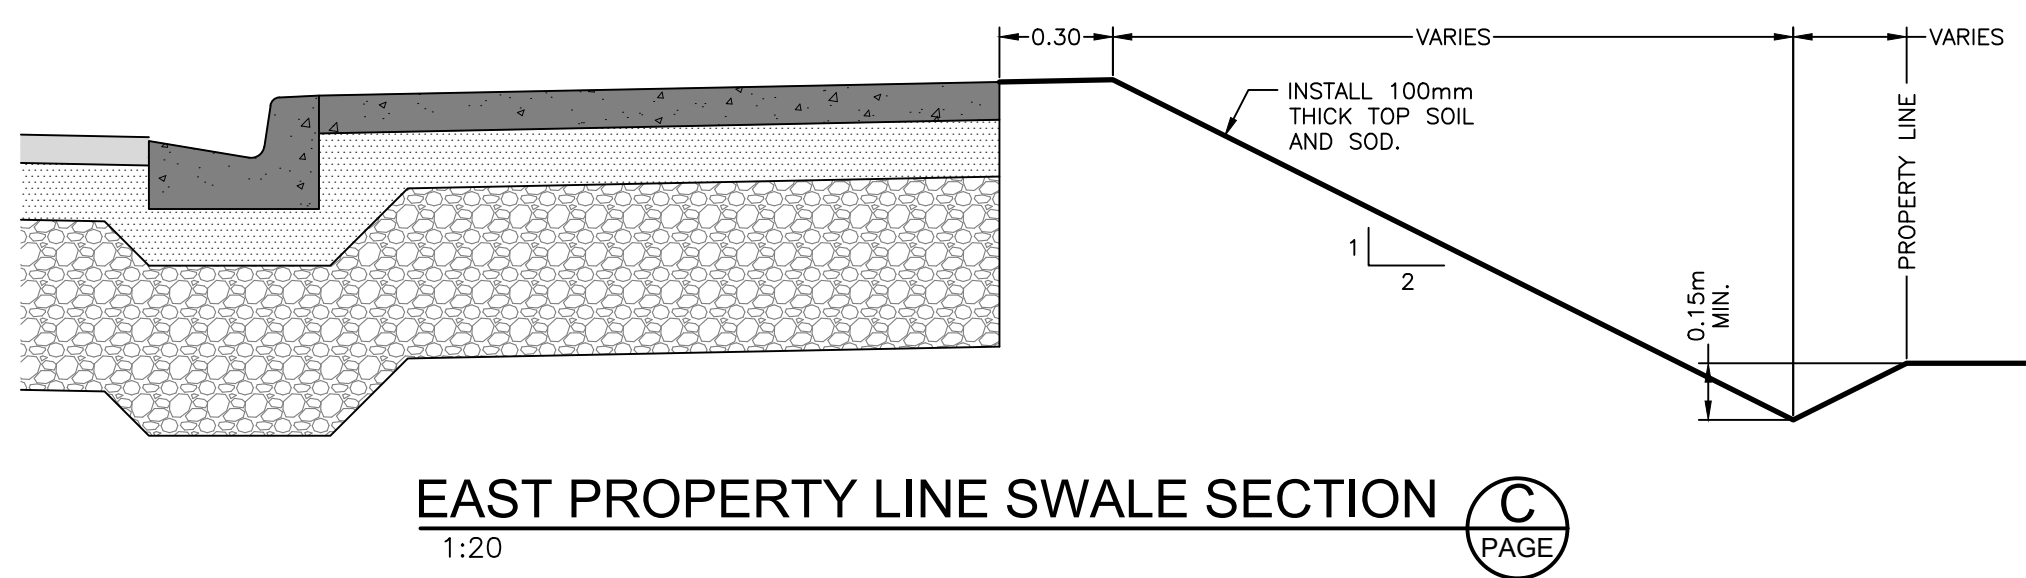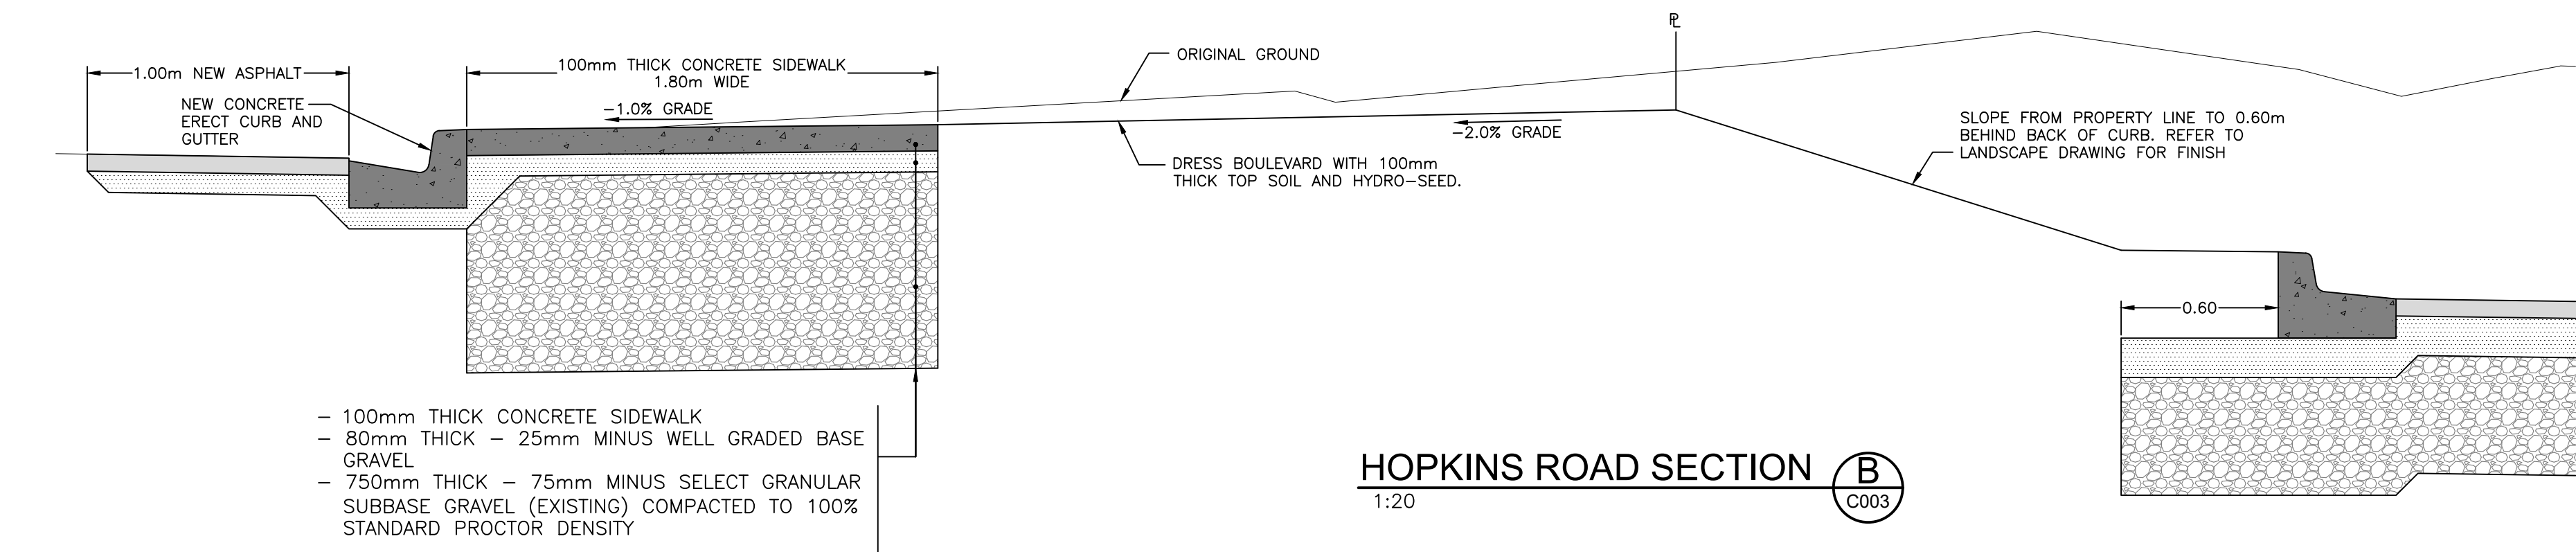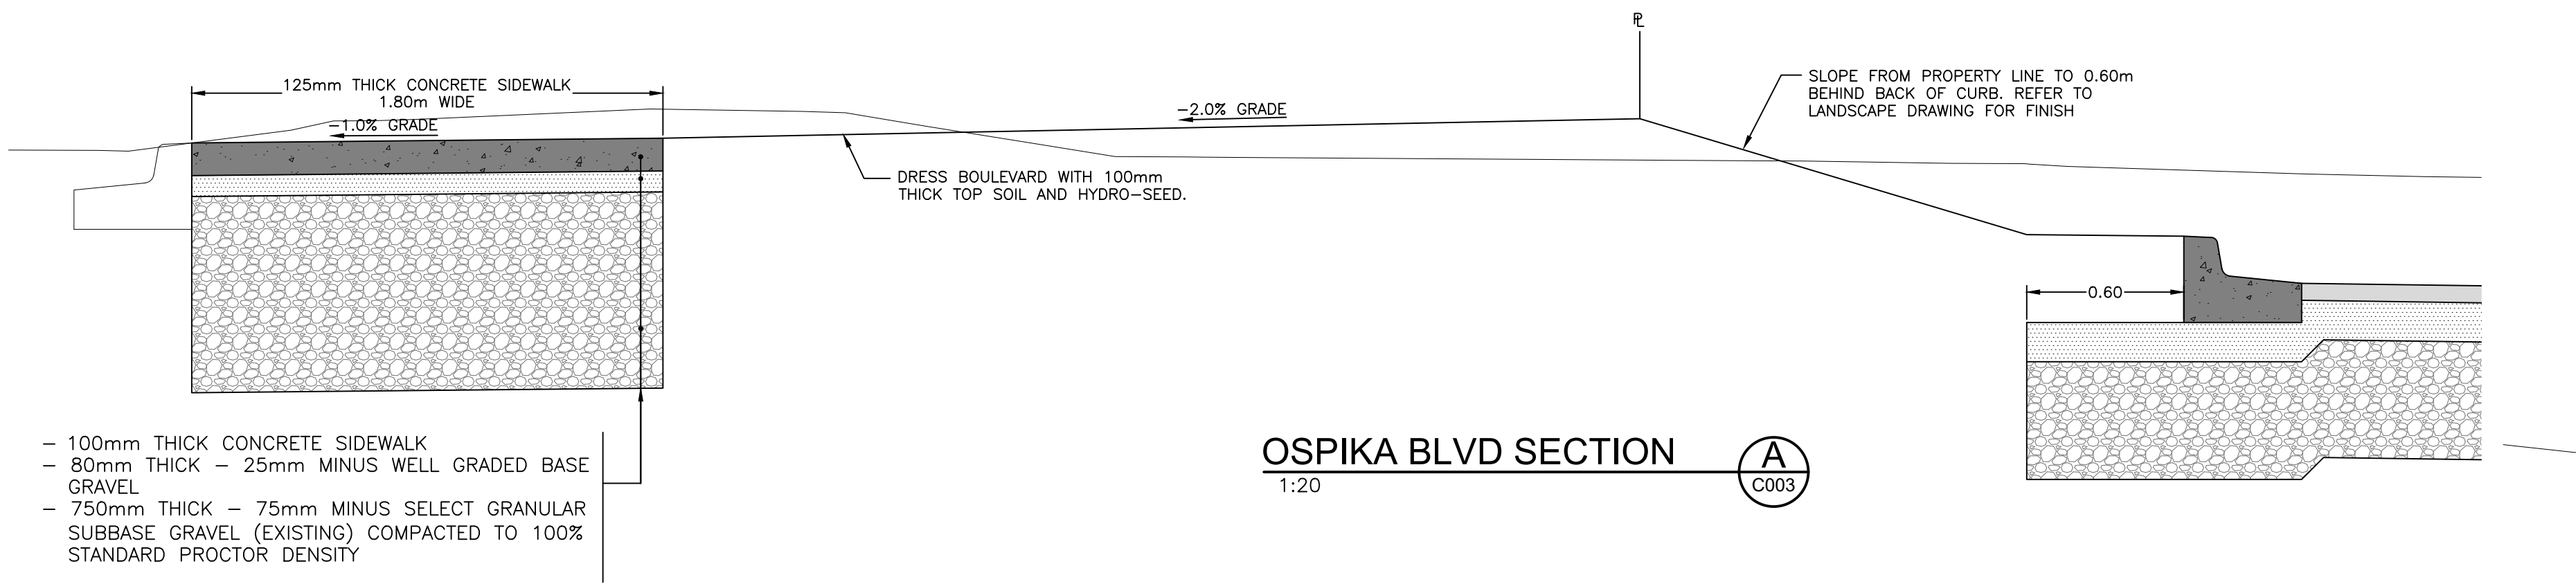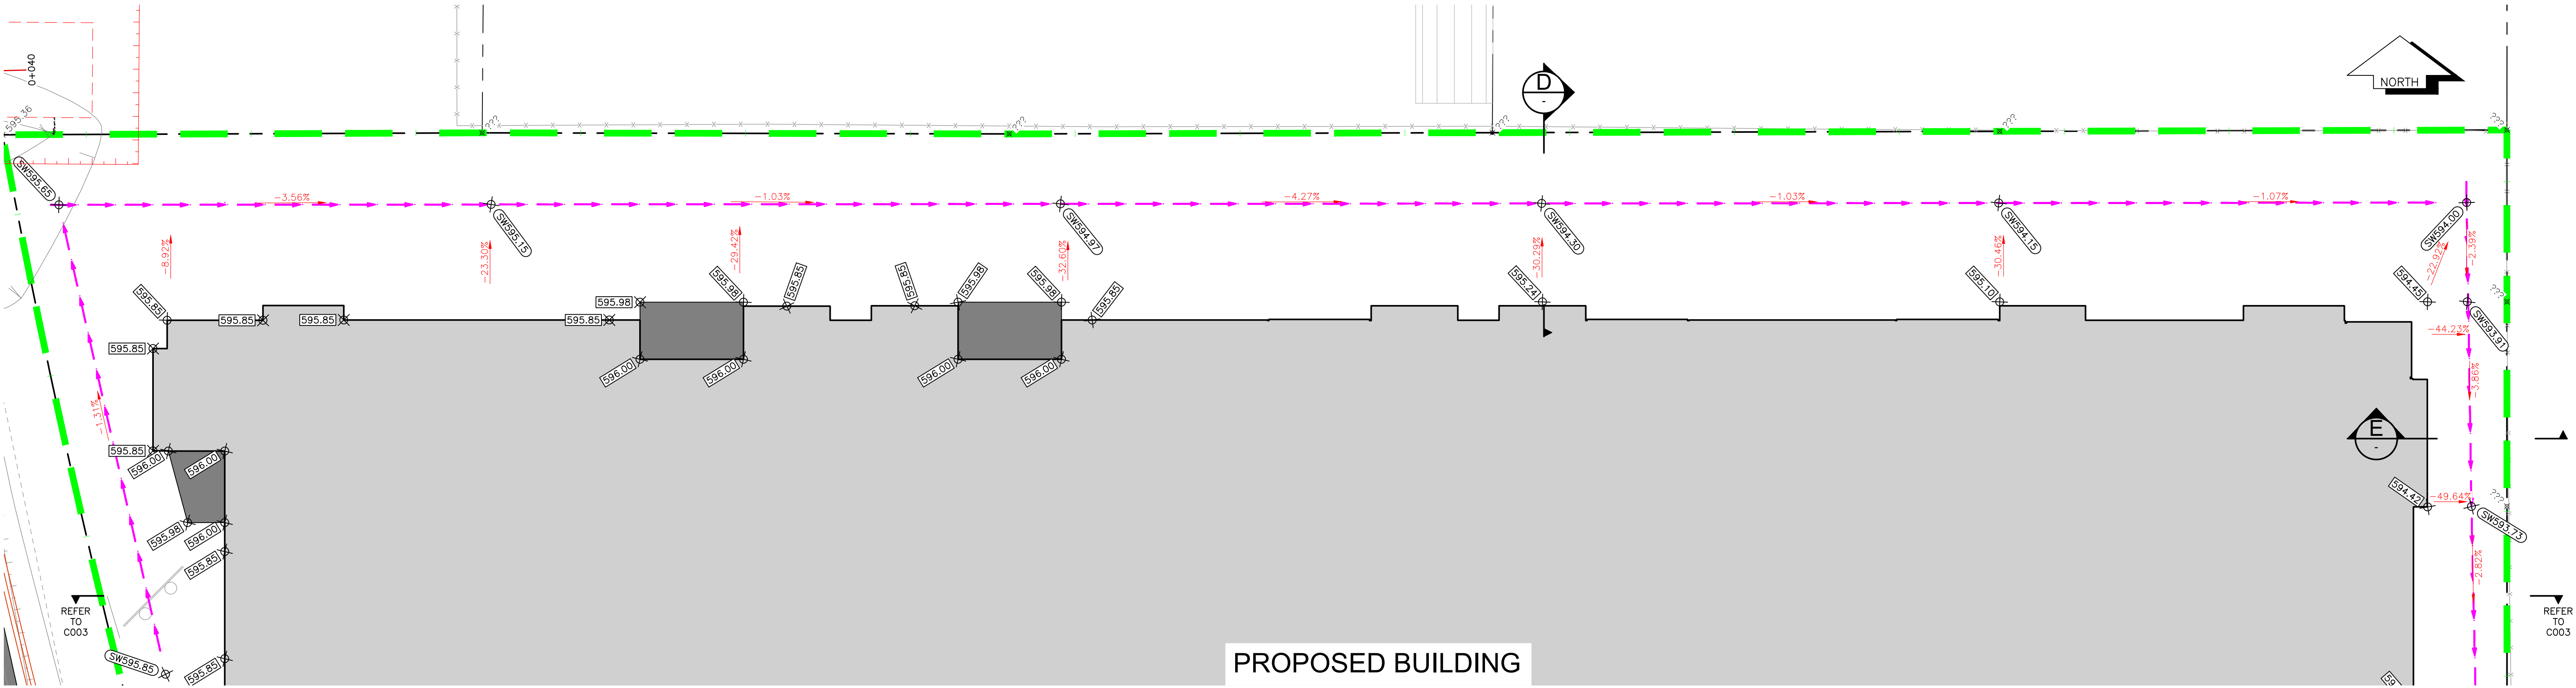

The City of Prince George does not represent or guarantee that the information contained in this document is accurate or reliable, and any person who relies on this information in this document does so at their own risk.

THE SEAL AND SIGNATURE OF THE UNDERSIGNED ON THIS DRAWING CERTIFIES THAT THE DESIGN INFORMATION CONTAINED IN THESE DRAWINGS ACCURATELY REFLECTS THE ORIGINAL DESIGN AND THE MATERIAL DESIGN CHANGES MADE DURING CONSTRUCTION, THAT WERE BROUGHT TO THE UNDERSIGNED'S ATTENTION. THESE DRAWINGS ARE INTENDED TO INCORPORATE ADDENDA, CHANGE ORDERS AND OTHER MATERIAL DESIGN CHANGES, BUT NOT NECESSARILY ALL SITE INSTRUCTIONS. THE UNDERSIGNED DOES NOT WARRANT OR GUARANTEE, NOR ACCEPT ANY RESPONSIBILITY FOR THE ACCURACY OR COMPLETENESS OF THE AS-CONSTRUCTED INFORMATION SUPPLIED BY OTHERS CONTAINED IN THESE DRAWINGS, BUT DOES, BY SEALING AND SIGNING, CERTIFY THAT THE AS CONSTRUCTED INFORMATION, IF ACCURATE AND COMPLETE, PROVIDES AN AS-CONSTRUCTED SYSTEM WHICH SUBSTANTIALLY COMPLIES IN ALL MATERIAL RESPECTS WITH THE ORIGINAL DESIGN INTENT.

6	23/5/23	RECORD DRAWING
5	7/5/2021	ISSUED FOR CONSTRUCTION
4	27/04/2021	UPDATED AS PER CITY COMMENTS
3	29/03/2021	RE-ISSUE BUILDING PERMIT
2	19/11/2020	ISSUED FOR BUILDING PERMIT
1	26/10/2020	ISSUED FOR REVIEW
No.	DATE	REVISION

PROJECT TITLE
2918 HOPKINS APARTMENT BUILDING

2918 HOPKINS ROAD
PRINCE GEORGE, BC

© Copyright reserved, this plan and design is and at all times remains the exclusive property of Chernoff Thompson Architects North and cannot be used without the architects consent.

All dimensions on the project must be checked by the contractor.

This drawing must not be used for construction purposes until here counter signed.

drawn: date:

PROFESSIONAL ENGINEER
T.A. FIELLSTROM
#20194
PERMIT TO PRACTICE
NO 1002375
2023-05-23

L&M
ENGINEERING LIMITED

1210 FOURTH AVENUE
PRINCE GEORGE, B.C.
V2L 3J4
TEL (250) 562-1977
FAX (250) 562-1967

SHEET TITLE
GRADING PLAN
SHT 2 of 2

PROJECT No. 1482-13
DRAWN JPA
CHECKED TAF
SCALE FULL, 1:100
DATE 31/03/2020
PRINTED 23/5/23

REVISION No.
C004

230-177 VICTORIA STREET, PRINCE GEORGE BC V2L 5R8
PHONE: (250) 564-7285 FAX: (250) 564-7286
ADMIN@CHC.HITECHTSNORTH.CA WWW.CHC.HITECHTSNORTH.CA

CHERNOFF THOMPSON ARCHITECTS NORTH