



The City of Prince George does not represent or guarantee that the information contained in this document is accurate or reliable, and any person who relies on this information in this document does so at their own risk.

City of Prince George
This information has been provided subject to the *Federal Copyright Act* and in accordance with the *Provincial Freedom of Information and Protection of Privacy Act*

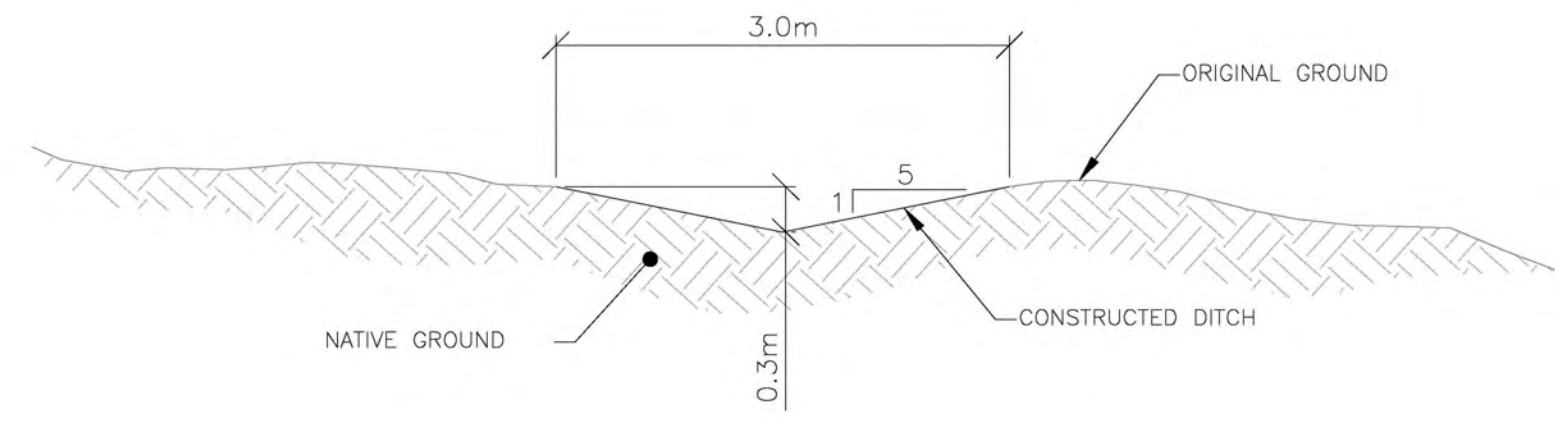

TYPICAL DRAINAGE SWALE
SCALE 1:50

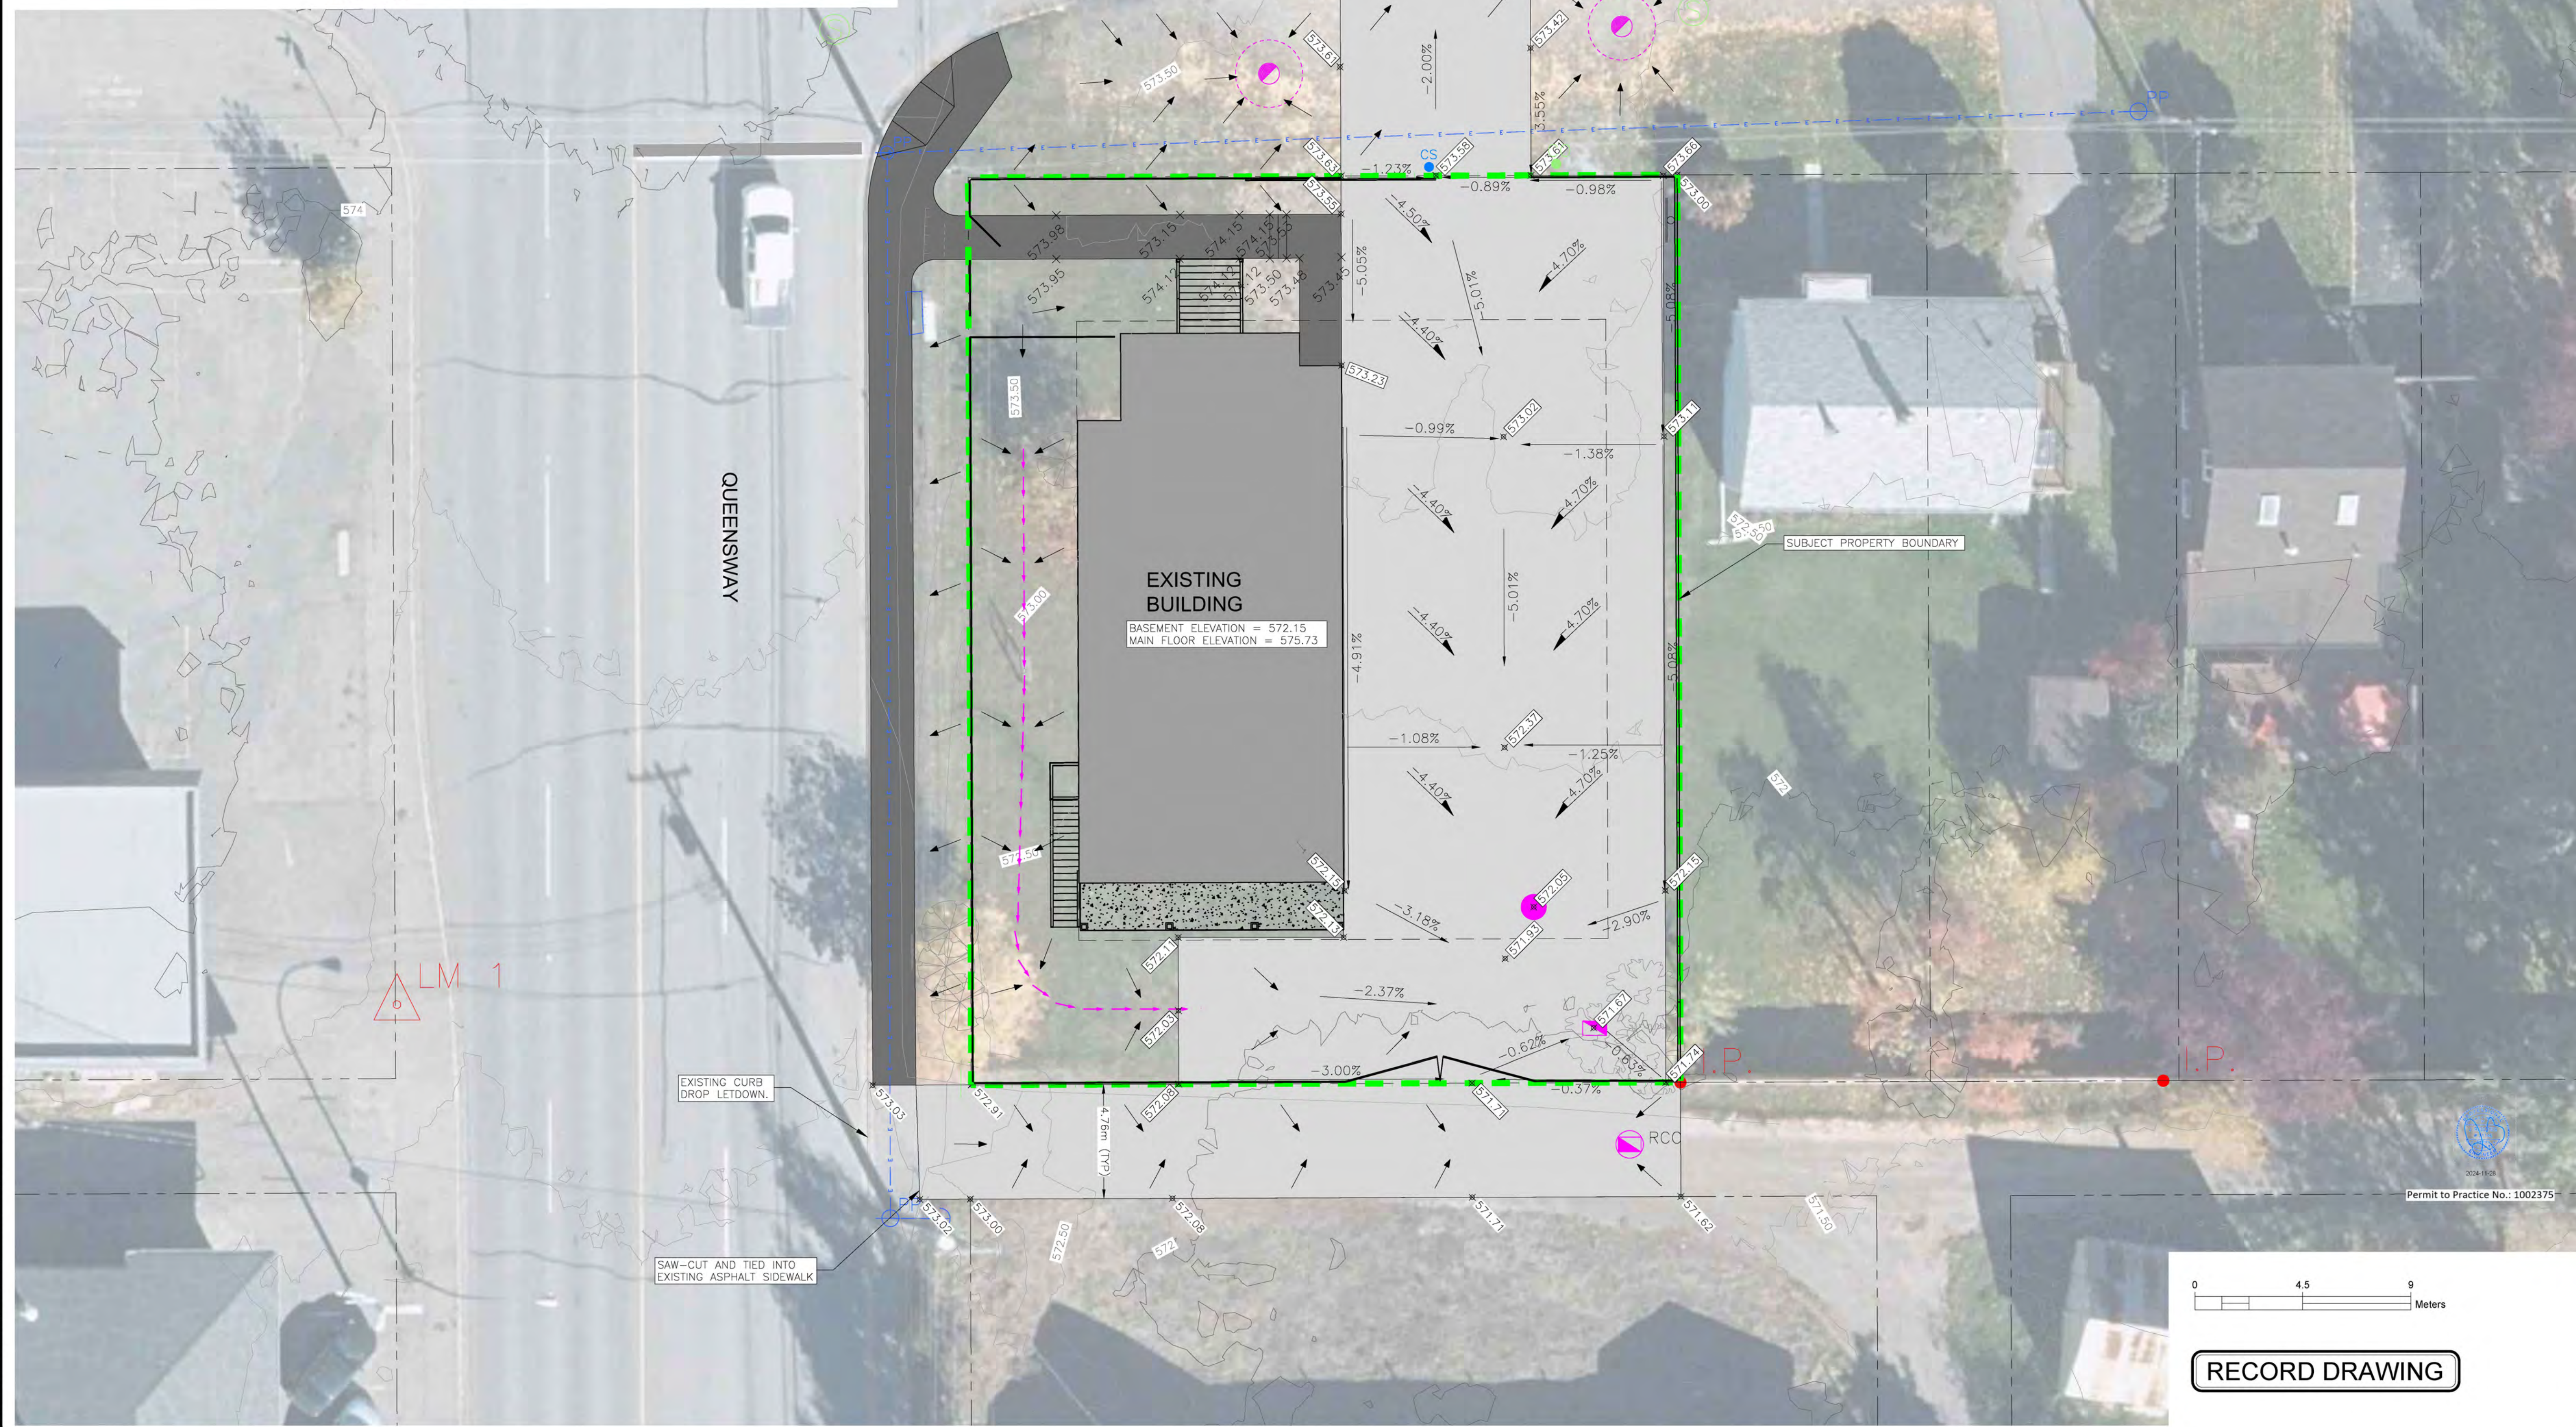

SURFACE LABEL LEGEND

| | |
|--------|--------------------------------|
| 00.00 | AS-BUILT ELEVATION |
| 000.00 | EXISTING GROUND ELEVATION |
| ↗ | GENERAL SURFACE FLOW DIRECTION |
| 0.00% | AS-BUILT GRADE |

LEGEND



EXISTING

- EX. TEST PIT & DRILL HOLE
- EX. BENCHMARK & SURVEY HUBS
- EX. IP'S & ISM'S
- EX. LEGAL LINE
- EX. LEGAL R.O.W. & EASEMENT
- EX. SANITARY & MANHOLE
- EX. SANITARY FORCE MAIN
- EX. STORM & MANHOLE
- EX. SINGLE & DOUBLE CATCHBASIN c/w CB LEADS
- EX. CATCHBASIN MANHOLE
- EX. CULVERT
- EX. FIRE HYDRANT & VALVE ASSEMBLY
- EX. WATERMAIN & VALVE
- EX. BLOW-OFF ASSEMBLY
- EX. CURB STOP
- EX. ROAD & SIDEWALK
- EX. ROAD SIGN(S)
- EX. SHOULDER
- EX. TOP OF SLOPE
- EX. TOE OF SLOPE
- EX. DITCH or SWALE
- EX. FENCE
- EX. OVERHEAD LINES
- EX. UNDERGROUND LINES
- EX. POWER POLE & ANCHOR
- EX. GAS MAIN

AS-BUILT

- AB. LEGAL LINE
- AB. LEGAL R.O.W. & EASEMENT
- AB. SANITARY & MANHOLE
- AB. STORM & MANHOLE
- AB. SINGLE & DOUBLE CATCHBASIN c/w CB LEADS
- AB. CATCHBASIN MANHOLE
- AB. CULVERT
- AB. DITCH or SWALE
- AB. FIRE HYDRANT & VALVE ASSEMBLY
- AB. WATERMAIN & VALVE
- AB. GRAVEL SHOULDER
- AB. ASPHALT
- AB. CURB & SIDEWALK
- AB. ROAD SIGN(S)

| | | | |
|-----|----------|----------------------------|-----|
| 5 | 09/09/24 | ISSUED FOR RECORD | MR |
| 4 | 06/07/21 | ISSUED FOR CONSTRUCTION | ZS |
| 3 | 05/07/21 | REPLACE SANITARY SERVICE | ZS |
| 2 | 14/08/20 | ADDED ASPHALT LANE | DDA |
| 1 | 16/06/20 | ISSUED FOR BUILDING PERMIT | DDA |
| 0 | 05/05/20 | ISSUED FOR REVIEW | DDA |
| NO. | DATE | REVISION | DR. |

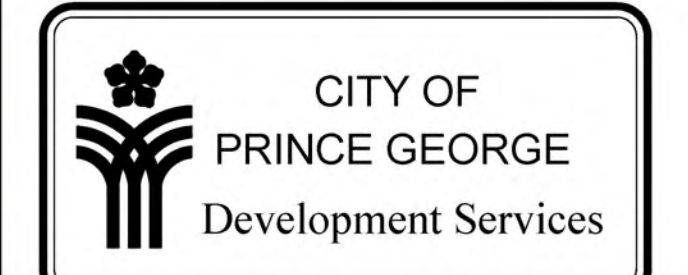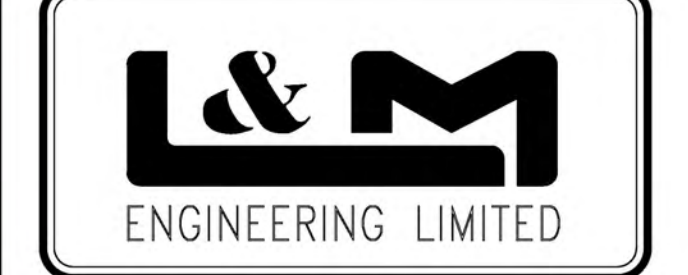

| | |
|-----------------|-----------------------------|
| DRAWN: | DDA |
| CHECKED: | DDA |
| ENGINEER: | JRB |
| SURVEY FILE: | |
| DRAWING FILE: | C:3D20 1706-01 AS-BUILT.dwg |
| CORRESPONDENCE: | CPG |
| GRID: | |
| DATE: | 18/03/2020 |
| SCALES: | HALF 1:400 FULL 1:200 |

965 LaSALLE AVENUE
PROPOSED NEW CHURCH

GRADING PLAN

CONSULTANTS PROJECT No.
1706-01

DRAWING No.
AB-C002

| | |
|-----------|----------|
| SHEET No. | REV. No. |
| 2 OF 4 | 2 |

0 4.5 9 Meters

RECORD DRAWING

C:\Users\Amrasha.Vasudevan\Local\Temp\Karpulash... 186336\C3D20 1706-01 AS-BUILT.dwg