

DRAWING NOTES

1. SITE SURVEY COMPLETED BY KOEHLER LAND SURVEYING INC.

2. POND SIDE SLOPE SHALL BE FILLED WITH MIN. 300mm THICK LOW PERMEABILITY SOIL AND COMPACTED TO 95% SPMD.

LEGEND

PROPERTY LINE

RIGHT OF WAY BOUNDARY

BUILDING SETBACK

TEL SERVICE - EX

JUNCTION BOX - EX

LIGHT STANDARD - EX & PR

CHAIN LINK FENCE - EX

CHAIN LINK FENCE - PR

CURB & CUTTER - EX

CURB & CUTTER - PR

SWALE - EX & PR

CONTOUR MINOR - EX

CONTOUR MAJOR - EX

CONTOUR MINOR - PR

CONTOUR MAJOR - PR

STORM MAIN - PR

STORM MAIN - EX

CUT & FILL SLOPE LIMITS

LIMIT OF GRADING WORK

REFERENCE DRAWINGS

DWG No.

REV

PROJECT No.

PRODUCED BY

DRAWING REVISIONS

0

23.12.11

KN

KN

BC

RECORD DRAWING

CONSULTANT

Scouten ENGINEERING

201 - 1968 QUEENSWAY

PRINCE GEORGE • BC • V2L 1M2

info@scoutenengineering.com

T 250.562.7050

PRIME CONSULTANT

struo

PROJECT INFORMATION

THE VAULT STORAGE LTD.

6989 BOUNDARY COURT

SELF STORAGE

GRADING PLAN

PROJECT No.


DRAWING No.

REV

1569-01

C-103

0

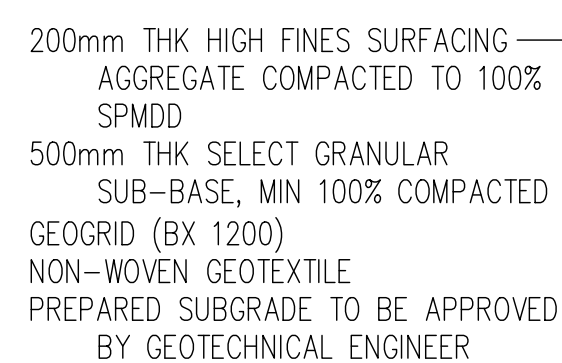

1:10

1:10



- | REFERENCE DRAWINGS | | | |
|--------------------|-----|-------------|-------------|
| DWG No. | REV | PROJECT No. | PRODUCED BY |
| | | | |
| | | | |

DRAWING REVISIONS					
0	23.12.11	KN	KN	BC	RECORD DRAWING
REV	DATE	DRW	DES	APP	REVISION

CONSULTANT

Scouten
ENGINEERING

201 - 1968 QUEENSWAY
PRINCE GEORGE • BC • V2L 1M2
info@scoutenengineering.com
T 250.562.7050

PRIME CONSULTANT

struō

PROJECT INFORMATION

THE VAULT STORAGE LTD.
6989 BOUNDARY COURT
SELF STORAGE

SECTION DETAILS

PROJECT No.	DRAWING No.	REV
1569-01	C-104	0

EGBC Permit to Practice No.: 1000556

RECORD DRAWING

