
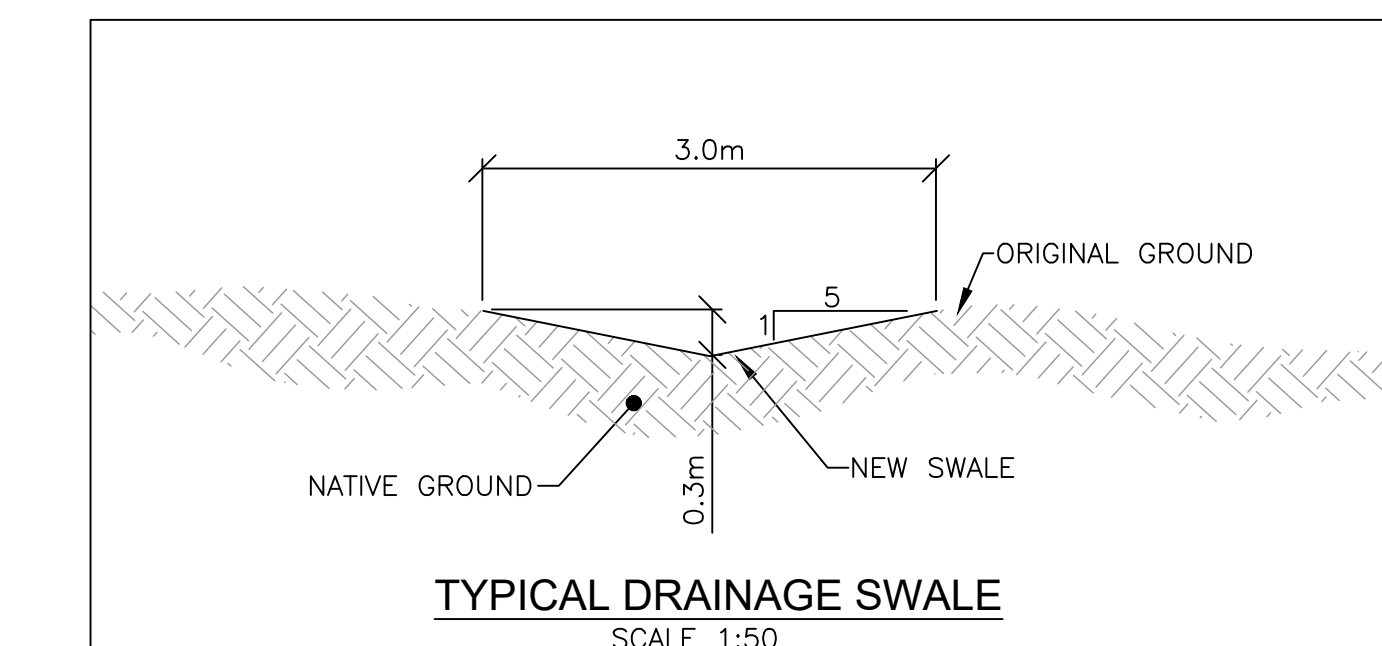
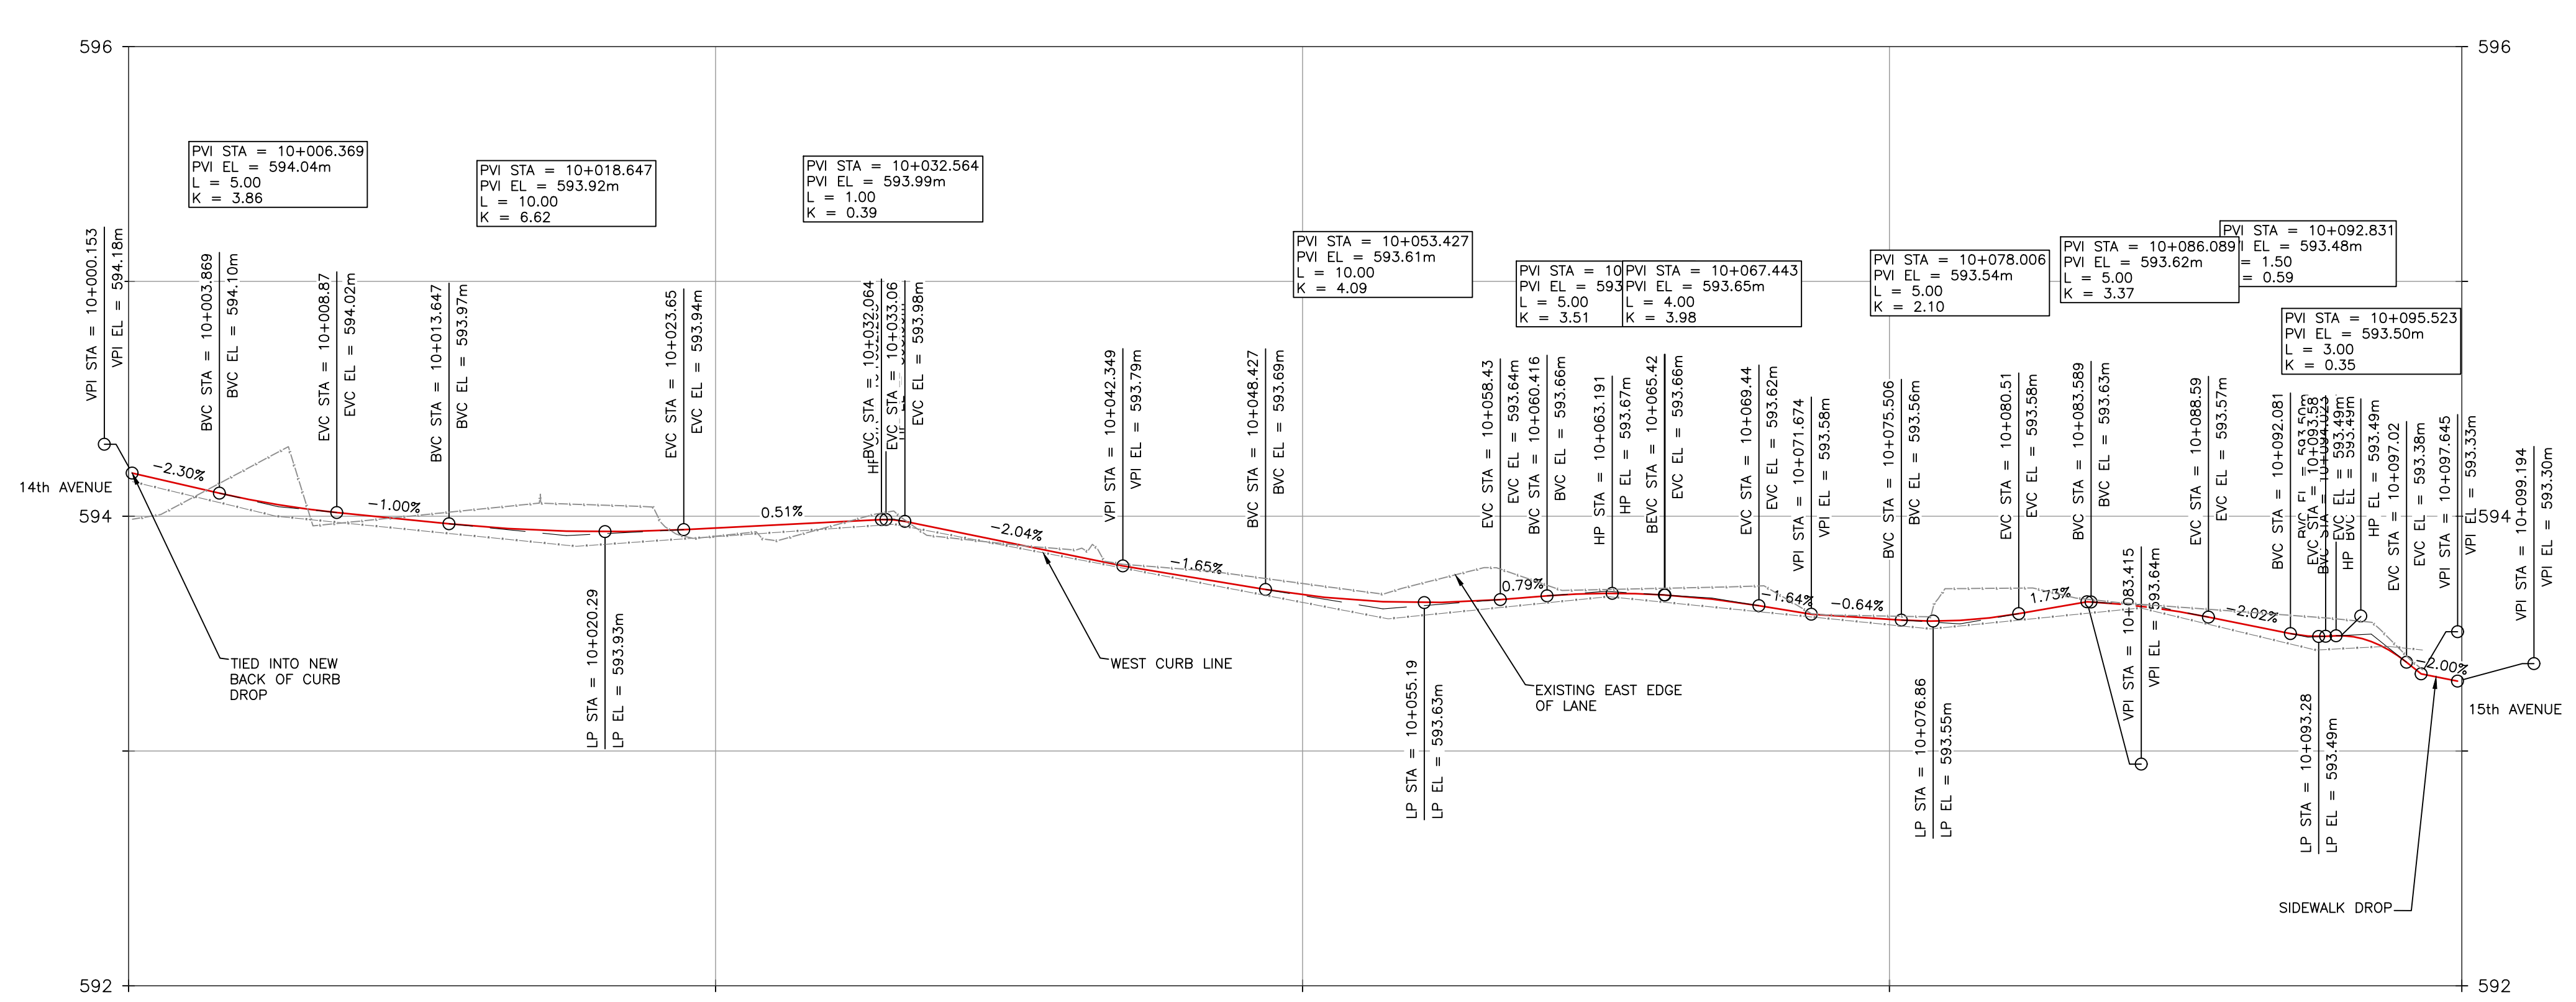


L&M
ENGINEERING LIMITED


1210 FOURTH AVENUE
PRINCE GEORGE, B.C.
V2L 3J4
TEL (250) 562-1977
FAX (250) 562-1967

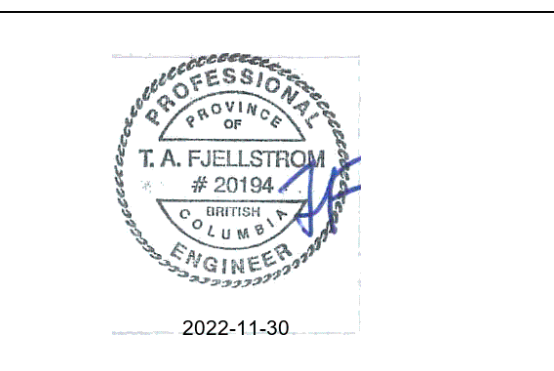

THE SEAL AND SIGNATURE OF THE UNDERSIGNED ON THIS DRAWING CERTIFIES THAT THE DESIGN INFORMATION CONTAINED IN THESE DRAWINGS ACCURATELY REFLECTS THE ORIGINAL DESIGN AND THE MATERIAL DESIGN CHANGES MADE DURING CONSTRUCTION, THAT WERE BROUGHT TO THE UNDERSIGNED'S ATTENTION. THESE DRAWINGS ARE INTENDED TO INCORPORATE ADDENDA, CHANGE ORDERS AND OTHER MATERIAL DESIGN CHANGES, BUT NOT NECESSARILY ALL SITE INSTRUCTIONS. THE UNDERSIGNED DOES NOT WARRANT OR GUARANTEE, NOR ACCEPT ANY RESPONSIBILITY FOR THE ACCURACY OR COMPLETENESS OF THE AS-CONSTRUCTED INFORMATION SUPPLIED BY OTHERS CONTAINED IN THESE DRAWINGS, BUT DOES, BY SEALING AND SIGNING, CERTIFY THAT THE AS-CONSTRUCTED INFORMATION, IF ACCURATE AND COMPLETE, PROVIDES AN AS-CONSTRUCTED SYSTEM WHICH SUBSTANTIALLY COMPLIES IN ALL MATERIAL RESPECTS WITH THE ORIGINAL DESIGN INTENT.

The City of Prince George does not represent or guarantee that the information contained in this document is accurate or reliable, and any person who relies on this information in this document does so at their own risk.

City of Prince George
This information has been provided subject to the Federal Copyright Act and in accordance with the Provincial Freedom of Information and Protection of Privacy Act.

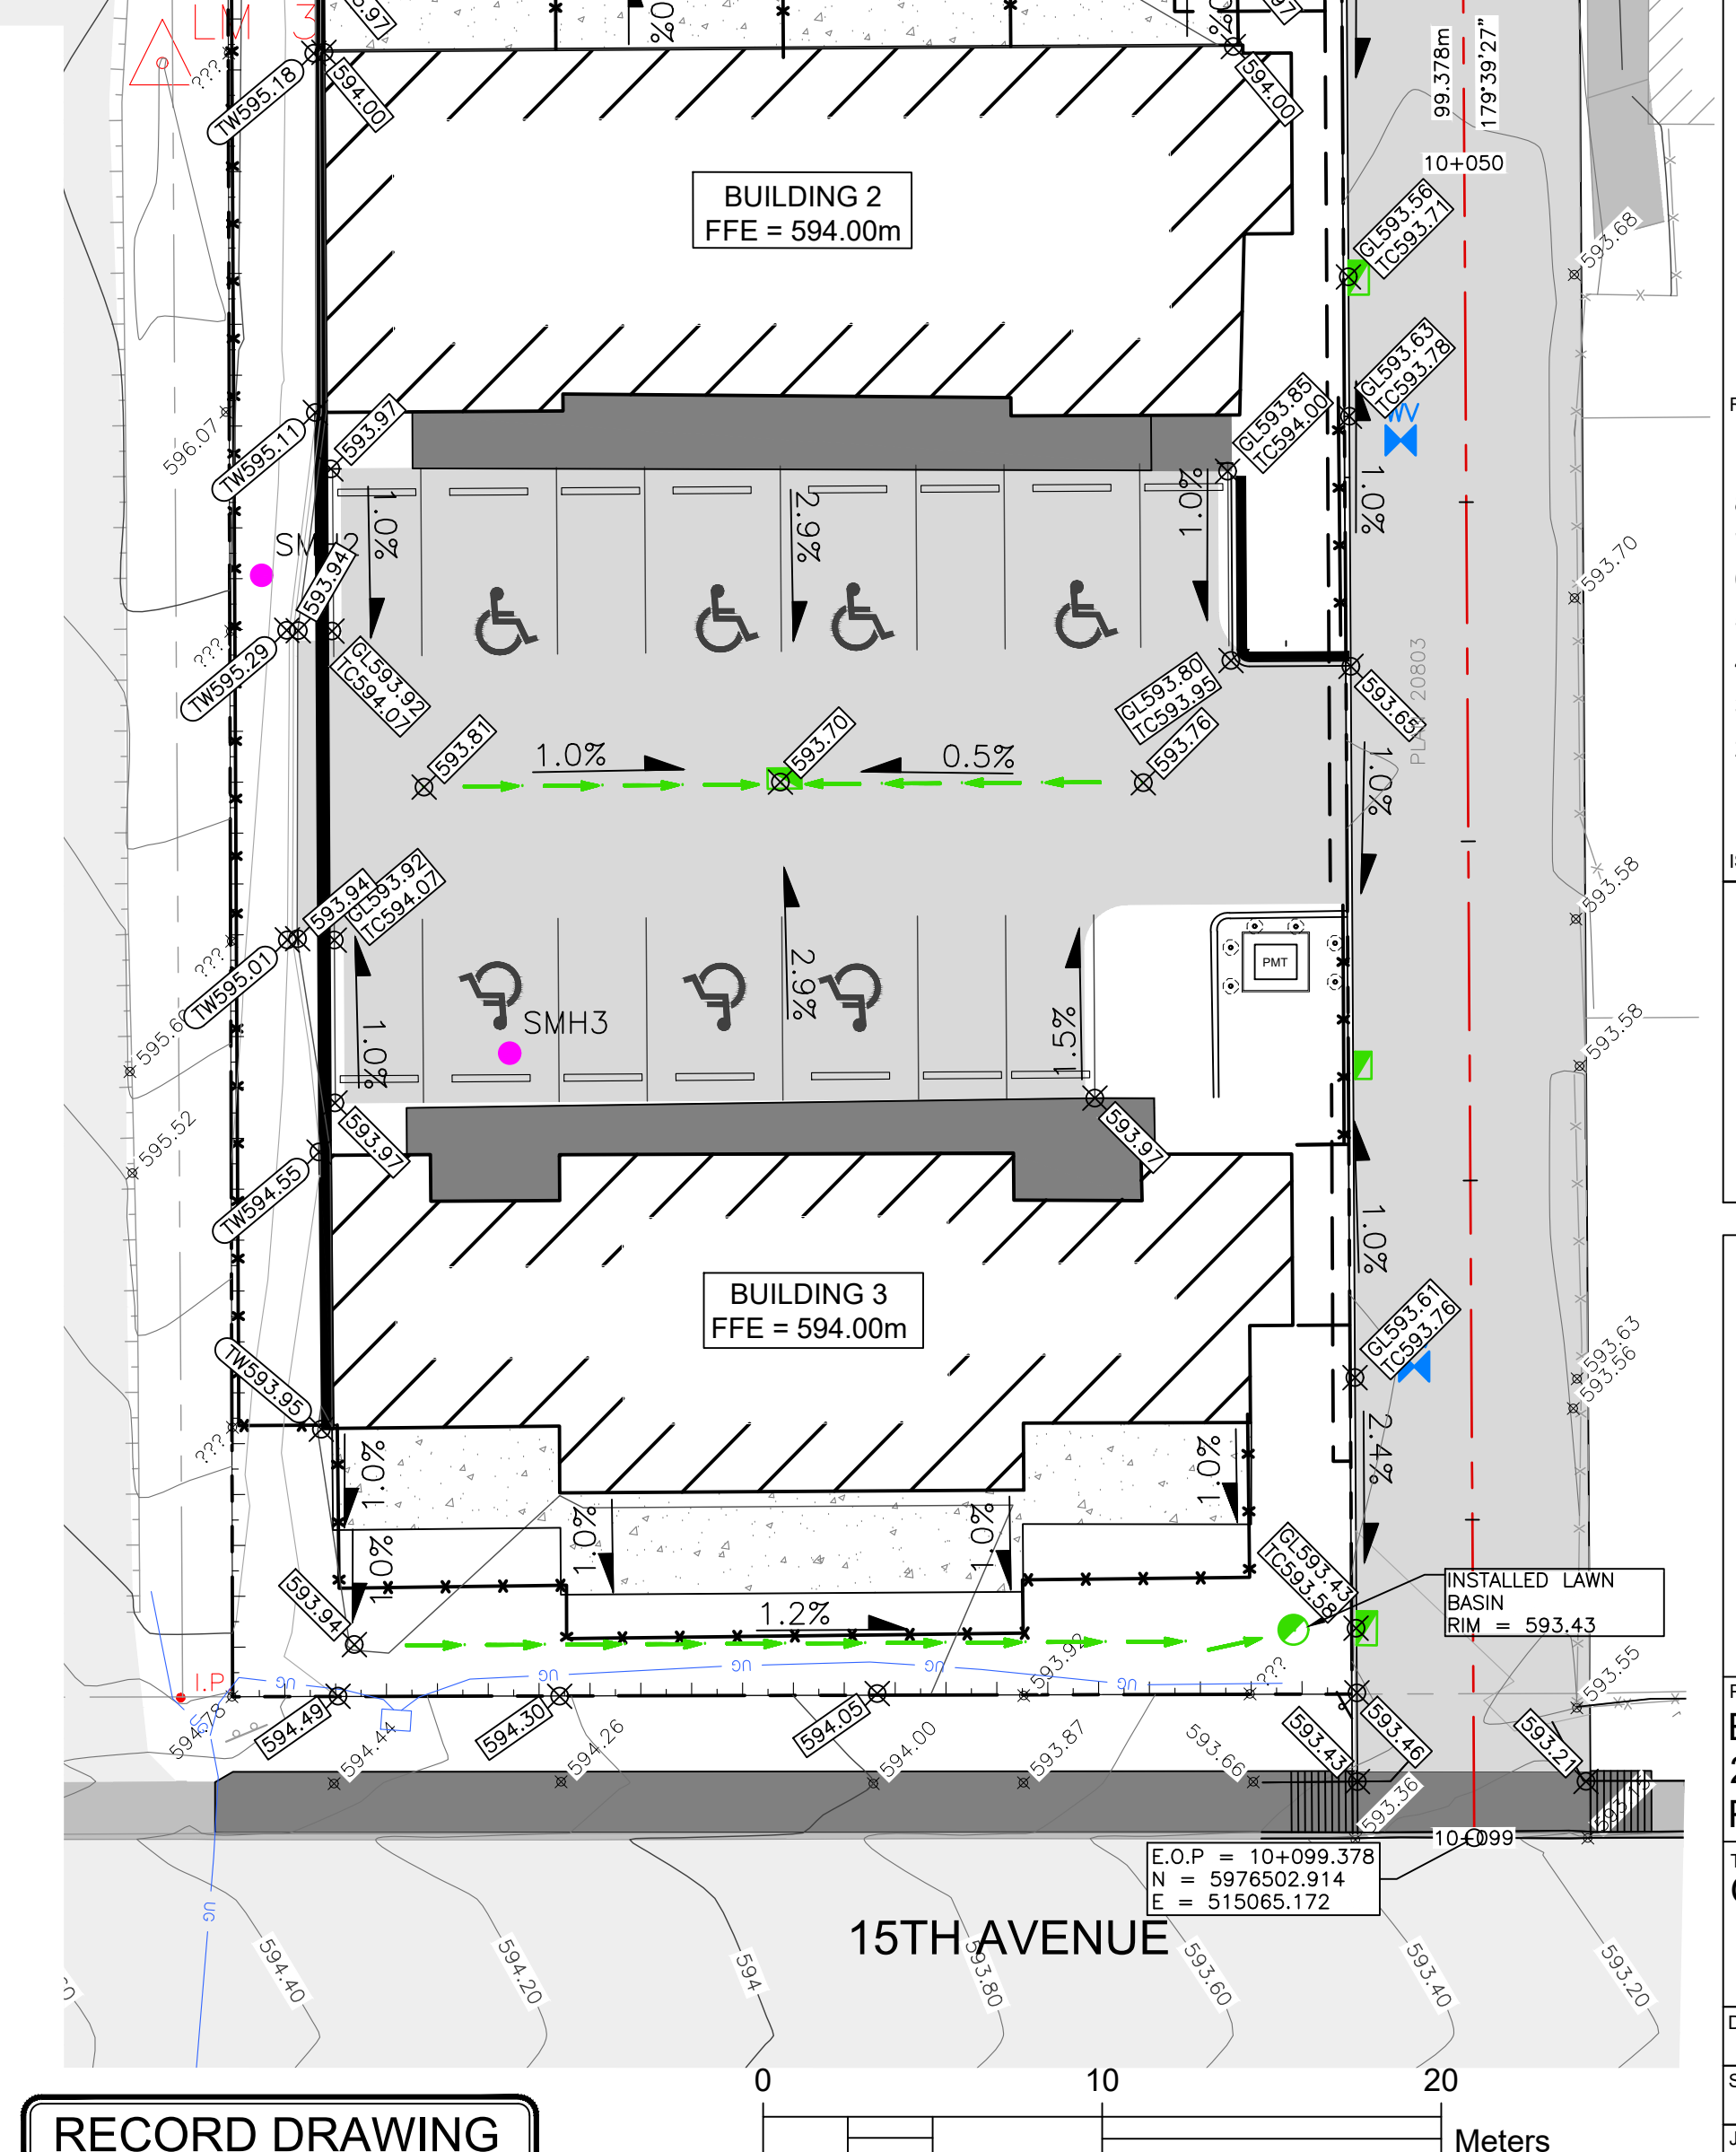

- REVISIONS:
- 8 22-11-30 RECORD DRAWING
 - 7 20-11-12 REV PER CITY COMMENTS
 - 6 20-11-5 REV PER CITY COMMENTS
 - 5 20-6-25 ISSUED FOR CONSTRUCTION
 - 4 20-6-15 REV PER CITY COMMENTS
 - 3 20-2-28 ISSUED FOR TENDER & BP
 - 2 19-8-9 ISSUED FOR BP
 - 1 19-1-25 ISSUED FOR DP
 - 0 18-11-21 FOR COORDINATION

COPYRIGHT RESERVED. THE COPYRIGHT TO THIS DRAWING AND ITS CONTENTS IS RESERVED, AND REMAINS AT ALL TIMES THE EXCLUSIVE PROPERTY OF BONI-MADDISON ARCHITECTS, AND SHALL NOT BE USED, MODIFIED, OR REPRODUCED WITHOUT THE EXPRESSED WRITTEN CONSENT OF BONI-MADDISON ARCHITECTS.

DIMENSIONS: THE CONTRACTOR SHALL VERIFY ALL DIMENSIONS, AND IMMEDIATELY REPORT ANY ERRORS AND/OR OMISSIONS. DO NOT SCALE DRAWINGS.

BONI • MADDISON
Architects

3732 West Broadway
Vancouver, B.C., V6R 2C1
T: 604 688 5894
F: 604 688 5899
E: info@bonimaddison.com

PROJECT: E.FRY HOUSING PROJECT
2588 14TH AVE
PRINCE GEORGE BC

TITLE: GRADING PLAN

DRAWN: KP	DRAWING NO: C004RD
SCALE: 1:200	JOB NO: 1254-07
DATE: 25FEB2020	REV. NO: 5