
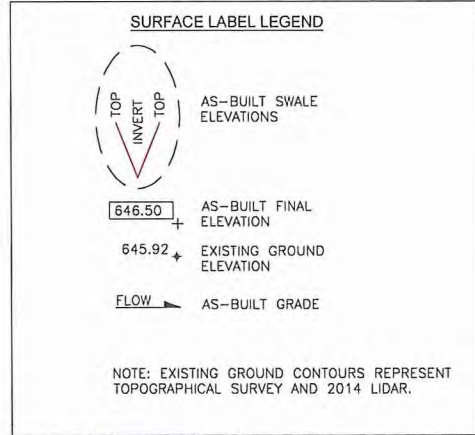


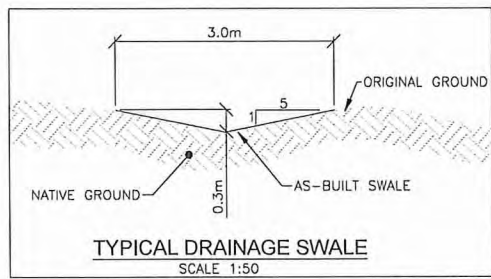

LEGEND

EXISTING

- EX. TEST PIT & DRILL HOLE
- EX. BENCHMARK & SURVEY HUBS
- EX. IP's & ISM's
- EX. LEGAL LINE
- EX. LEGAL R.O.W. & EASEMENT
- EX. SANITARY & MANHOLE
- EX. SANITARY FORCE MAIN
- EX. STORM & MANHOLE
- EX. SINGLE & DOUBLE CATCHBASIN w/ CB LEADS
- EX. CATCHBASIN MANHOLE
- EX. CULVERT
- EX. FIRE HYDRANT & VALVE ASSEMBLY
- EX. WATERMAIN & VALVE
- EX. BLOW-OFF ASSEMBLY
- EX. CURB STOP
- EX. ROAD & SIDEWALK
- EX. ROAD SIGN(s)
- EX. SHOULDER
- EX. TOP OF SLOPE
- EX. TOE OF SLOPE
- EX. DITCH or SWALE
- EX. FENCE
- EX. OVERHEAD LINES
- EX. UNDERGROUND LINES
- EX. POWER POLE & ANCHOR
- EX. GAS MAIN

AS-BUILT



- AB. LEGAL LINE
- AB. LEGAL R.O.W. & EASEMENT
- AB. SANITARY & MANHOLE
- AB. STORM & MANHOLE
- AB. SINGLE & DOUBLE CATCHBASIN w/ CB LEADS
- AB. CATCHBASIN MANHOLE
- AB. CULVERT
- AB. DITCH or SWALE
- AB. FIRE HYDRANT & VALVE ASSEMBLY
- AB. WATERMAIN & VALVE
- AB. GRAVEL SHOULDER
- AB. ASPHALT
- AB. CURB & SIDEWALK
- AB. ROAD SIGN(s)

NO.	DATE	REVISION	DR.
3	06/11/19	ISSUED FOR RECORD DRAWING	MM
2	31/05/19	ISSUED FOR CONSTRUCTION	KP
1	26/06/18	ISSUED FOR REVIEW	KP
0	20/01/17	ISSUED FOR REVIEW	KP

City of Prince George

This information has been provided subject to the *Federal Copyright Act* and in accordance with the *Provincial Freedom of Information and Protection of Privacy Act*.

The City of Prince George does not represent or guarantee that the information contained in this document is accurate or reliable, and any person who relies on this information in this document does so at their own risk.

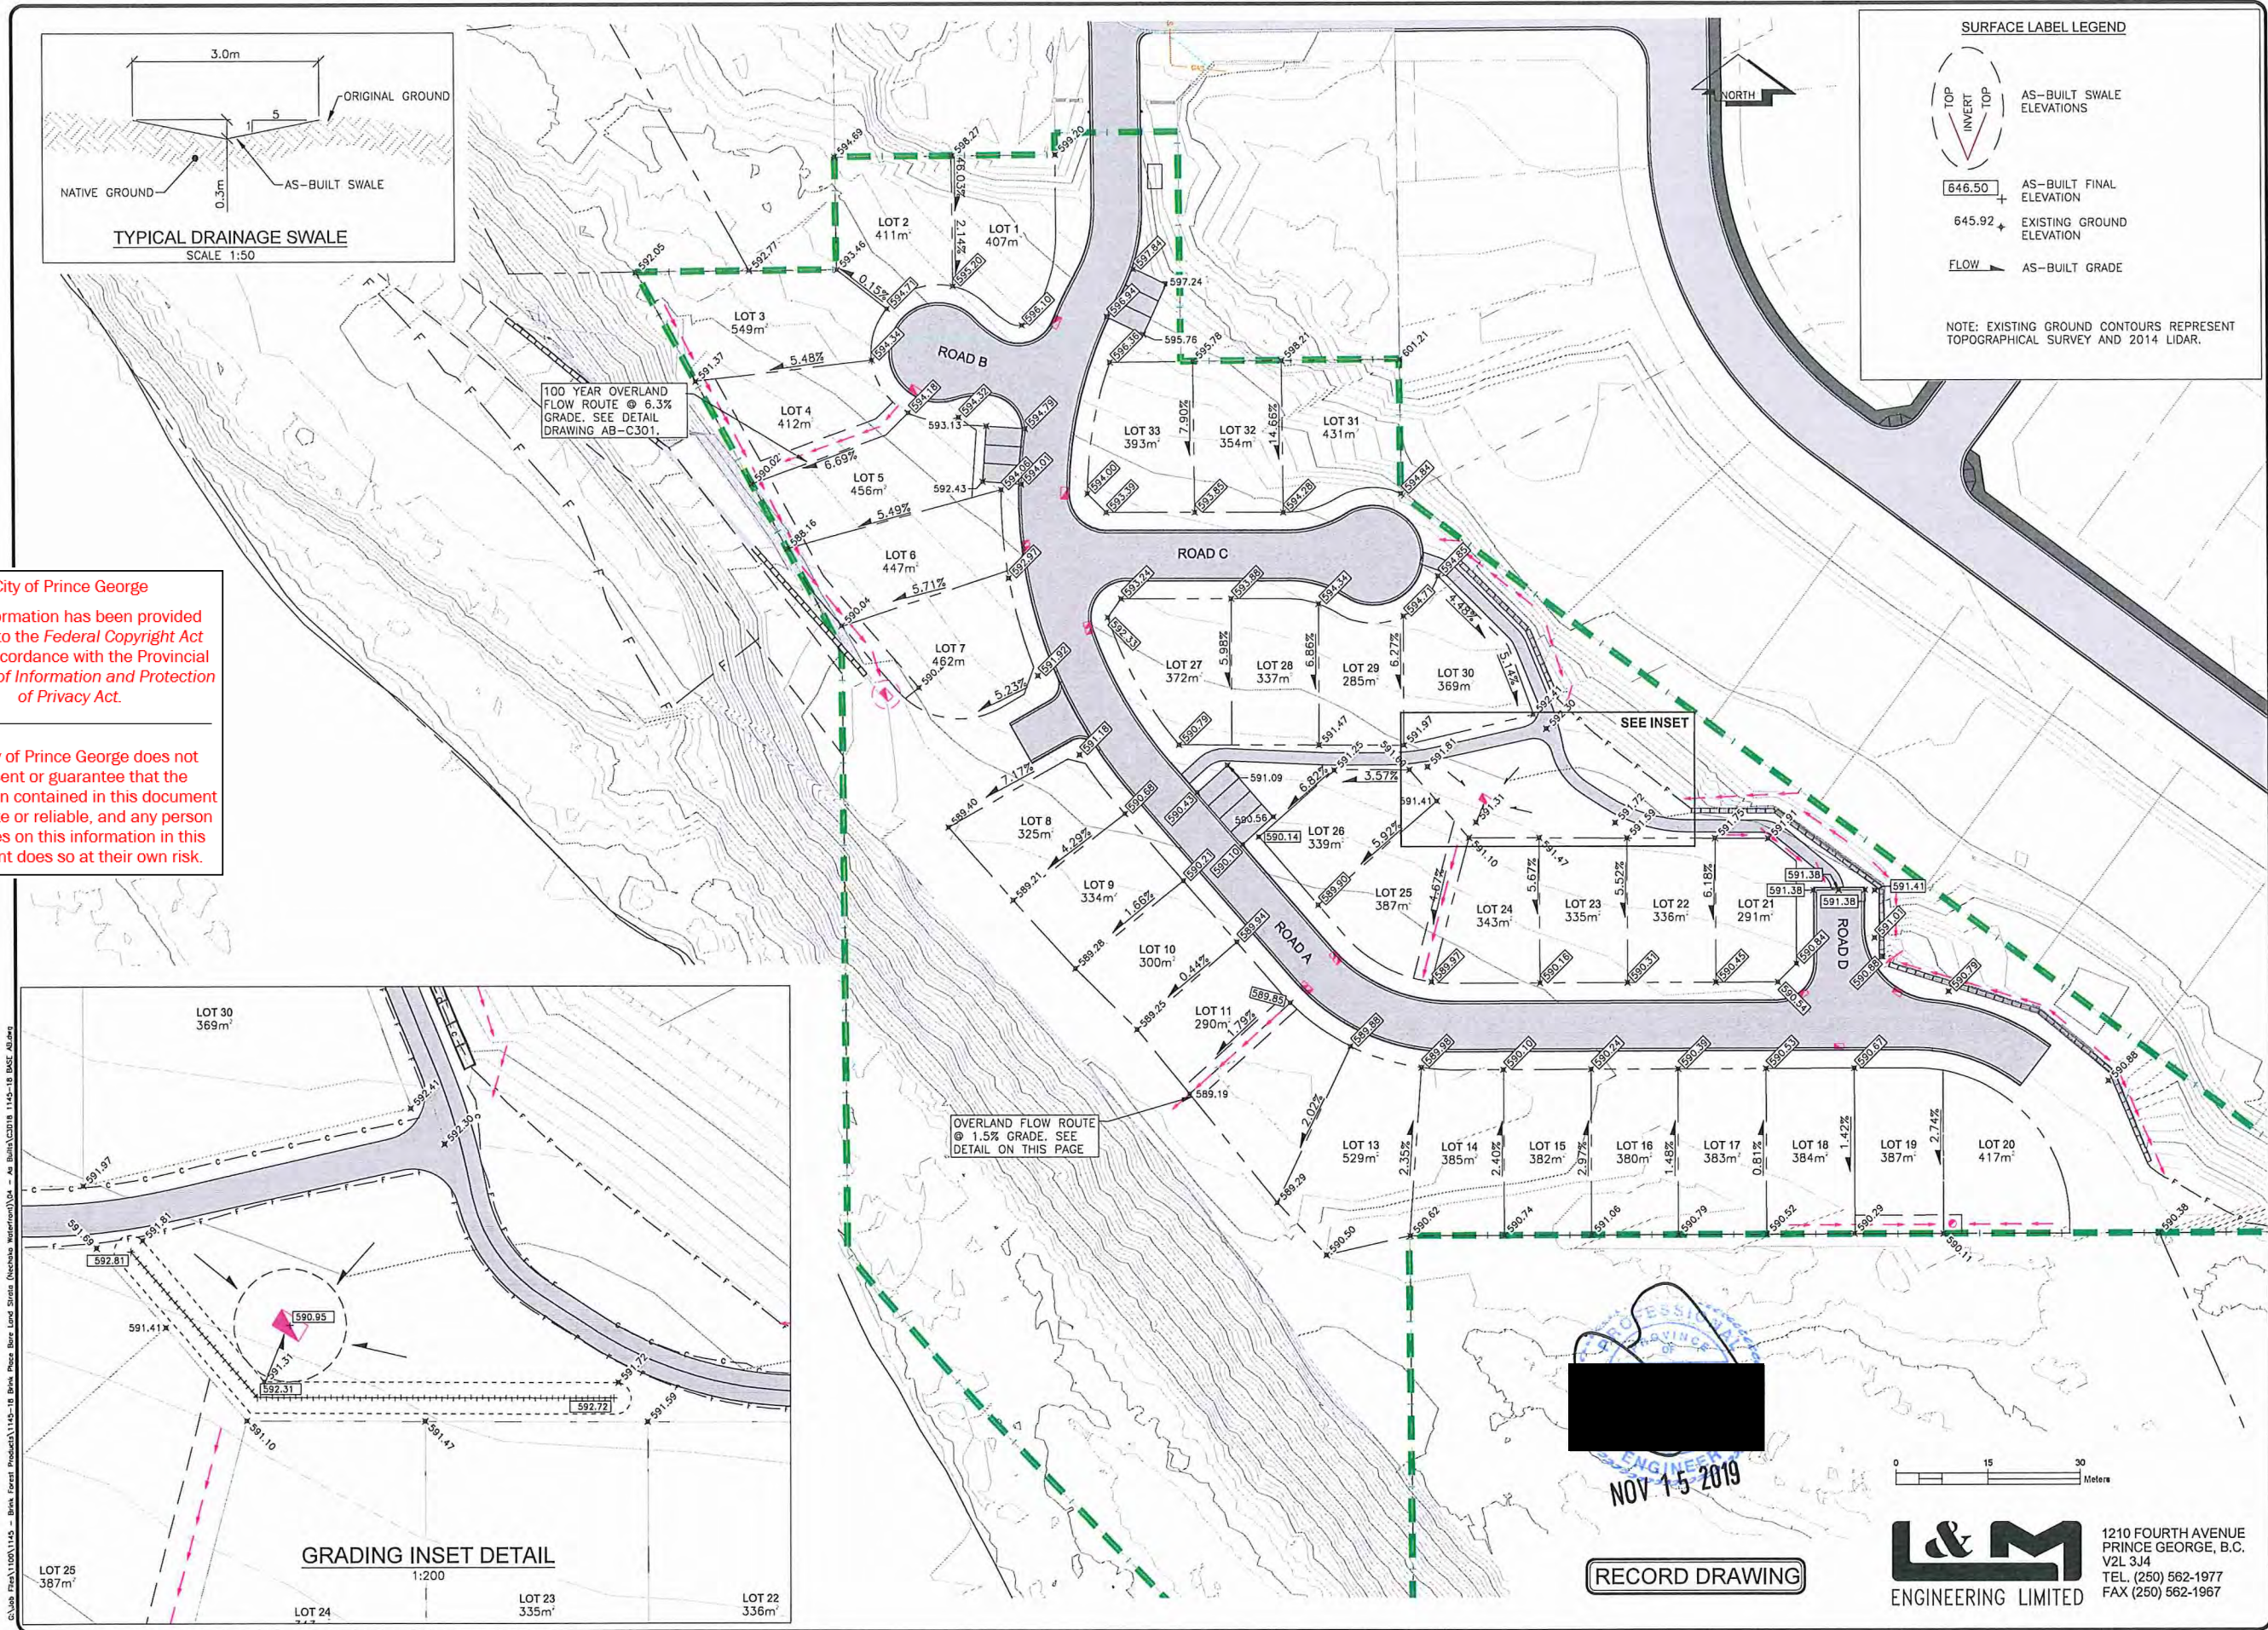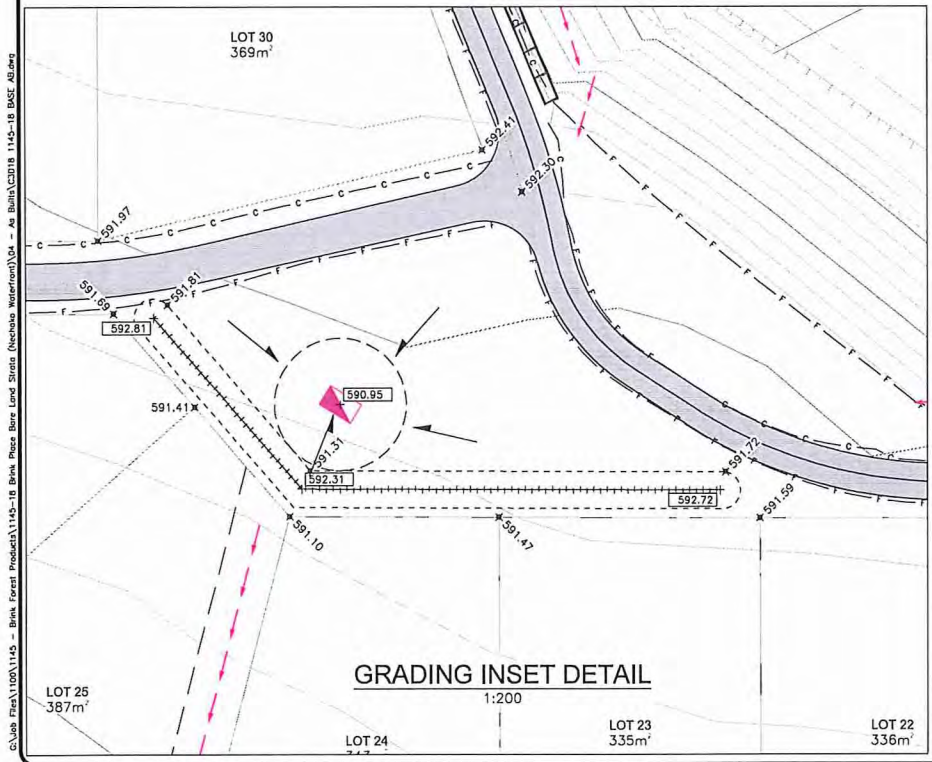

CITY OF PRINCE GEORGE
Development Services

DRAWN: KP
CHECKED: JRB
ENGINEER: JRB
SURVEY FILE:
DRAWING FILE: C3D18 1145-18 BASE AB-000
CORRESPONDENCE: CPG
GRID:
DATE: JANUARY 2017
SCALE: 1:500

THE BRINK GROUP
NECHAKO WATERFRONT
33 LOT BARE LAND STRATA

GRADING PLAN

CONSULTANT'S PROJECT No.
1145-18

DRAWING No.
AB-C003

SHEET No.
3 OF 3

REV. No.
3

L&M
ENGINEERING LIMITED

1210 FOURTH AVENUE
PRINCE GEORGE, B.C.
V2L 3J4
TEL. (250) 562-1977
FAX (250) 562-1967