

City of Prince George HISTORY SHEET


PID:	031-657-826
SD/MU:	SD100547
WO:	

CIVIC ADDRESS: 3668 MUNRO WAY

LEGAL DESCRIPTION: LOT 24 DISTRICT LOT 905 PLAN EPP108995

NOTE:

- 1. THE OCCUPANCY PERMIT WILL BE ISSUED BY THE CITY OF PRINCE GEORGE WHEN THE LOT GRADING AND/OR DRAINAGE SWALES CONFORM TO THE DESIGN AND TO THE SATISFACTION OF THE CITY OF PRINCE GEORGE BUILDING INSPECTOR.
- 2. ELEVATIONS SHOWN ARE FINAL LOT ELEVATIONS.

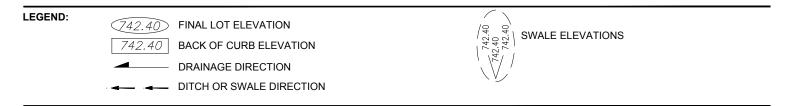

THE INFORMATION CONTAINED HEREIN IS FOR INTERNAL USE ONLY. NOT TO BE RELIED UPON UNLESS CONFIRMED BY SITE INVESTIGATION.

