



CITY OF PRINCE GEORGE

# City of Prince George HISTORY SHEET

PID:	031-658-032
SD/MU:	SD100547
WO:	

CIVIC ADDRESS: 2953 MUNRO WAY


LEGAL DESCRIPTION: LOT 45 DISTRICT LOT 905 PLAN EPP108995

**NOTE:**

1. THE OCCUPANCY PERMIT WILL BE ISSUED BY THE CITY OF PRINCE GEORGE WHEN THE LOT GRADING AND/OR DRAINAGE SWALES CONFORM TO THE DESIGN AND TO THE SATISFACTION OF THE CITY OF PRINCE GEORGE BUILDING INSPECTOR.
2. ELEVATIONS SHOWN ARE FINAL LOT ELEVATIONS.

**LEGEND:**

- 742.40 FINAL LOT ELEVATION
- 742.40 BACK OF CURB ELEVATION
- DRAINAGE DIRECTION
- DITCH OR SWALE DIRECTION

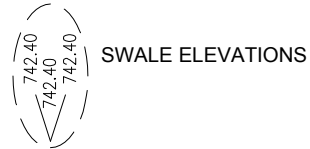

THE INFORMATION CONTAINED HEREIN IS FOR INTERNAL USE ONLY.  
NOT TO BE RELIED UPON UNLESS CONFIRMED BY SITE INVESTIGATION.

