

City of Prince George HISTORY SHEET


PID:	031-682-910
SD/MU:	SD100592
WO:	

CIVIC ADDRESS: 3165 LINKS DR

LEGAL DESCRIPTION: LOT 10 DISTRICT LOT 4041 PLAN EPP114714

NOTE:

- 1. THE OCCUPANCY PERMIT WILL BE ISSUED BY THE CITY OF PRINCE GEORGE WHEN THE LOT GRADING AND/OR DRAINAGE SWALES CONFORM TO THE DESIGN AND TO THE SATISFACTION OF THE CITY OF PRINCE GEORGE BUILDING INSPECTOR.
- 2. ELEVATIONS SHOWN ARE FINAL LOT ELEVATIONS.

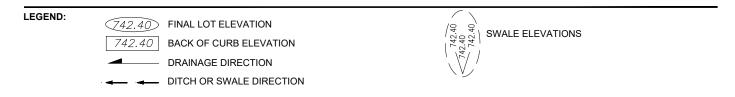

THE INFORMATION CONTAINED HEREIN IS FOR INTERNAL USE ONLY. NOT TO BE RELIED UPON UNLESS CONFIRMED BY SITE INVESTIGATION.

