



CITY OF PRINCE GEORGE

# City of Prince George HISTORY SHEET


PID:	031-811-957
SD/MU:	SD100658
WO:	

CIVIC ADDRESS: 5068 WOODVALLEY  
LEGAL DESCRIPTION: LOT 18 DISTRICT LOT 2425 PLAN EPP122550

**NOTE:**

1. THE OCCUPANCY PERMIT WILL BE ISSUED BY THE CITY OF PRINCE GEORGE WHEN THE LOT GRADING AND/OR DRAINAGE SWALES CONFORM TO THE DESIGN AND TO THE SATISFACTION OF THE CITY OF PRINCE GEORGE BUILDING INSPECTOR.
2. ELEVATIONS SHOWN ARE FINAL LOT ELEVATIONS.

**LEGEND:**

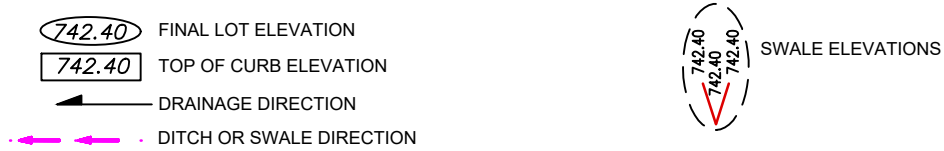

THE INFORMATION CONTAINED HEREIN IS FOR INTERNAL USE ONLY.  
NOT TO BE RELIED UPON UNLESS CONFIRMED BY SITE INVESTIGATION.

