



CITY OF PRINCE GEORGE

City of Prince George HISTORY SHEET

PID:	031-812-091
SD/MU:	SD100658
WO:	


CIVIC ADDRESS: 5319 BREANNA AVE

LEGAL DESCRIPTION: LOT 32 DISTRICT LOT 2425 PLAN EPP122550

NOTE:

1. THE OCCUPANCY PERMIT WILL BE ISSUED BY THE CITY OF PRINCE GEORGE WHEN THE LOT GRADING AND/OR DRAINAGE SWALES CONFORM TO THE DESIGN AND TO THE SATISFACTION OF THE CITY OF PRINCE GEORGE BUILDING INSPECTOR.
2. ELEVATIONS SHOWN ARE FINAL LOT ELEVATIONS.

LEGEND:

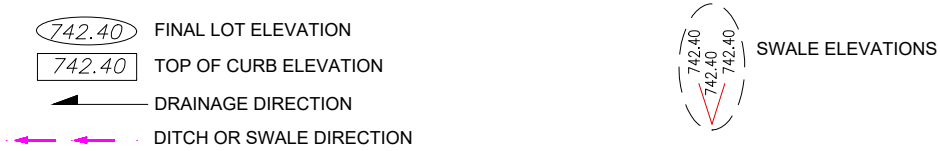

THE INFORMATION CONTAINED HEREIN IS FOR INTERNAL USE ONLY.
NOT TO BE RELIED UPON UNLESS CONFIRMED BY SITE INVESTIGATION.

