



# City of Prince George HISTORY SHEET

PID:	032-108-524
SD/MU:	SD100680
WO:	

CITY OF  
PRINCE GEORGE


CIVIC ADDRESS: 7882 SOUTHRIDGE AVE

LEGAL DESCRIPTION: LOT 5 DISTRICT LOT 1605 PLAN EPP131558

**NOTE:**

1. THE OCCUPANCY PERMIT WILL BE ISSUED BY THE CITY OF PRINCE GEORGE WHEN THE LOT GRADING AND/OR DRAINAGE SWALES CONFORM TO THE DESIGN AND TO THE SATISFACTION OF THE CITY OF PRINCE GEORGE BUILDING INSPECTOR.
2. ELEVATIONS SHOWN ARE FINAL LOT ELEVATIONS.

**LEGEND:**

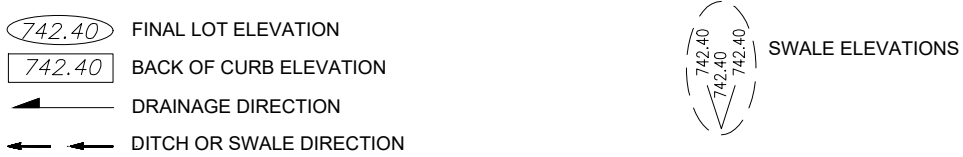

THE INFORMATION CONTAINED HEREIN IS FOR INTERNAL USE ONLY.  
NOT TO BE RELIED UPON UNLESS CONFIRMED BY SITE INVESTIGATION.

