

## City of Prince George HISTORY SHEET


PID:	032-239-203
SD/MU:	
WO:	

CIVIC ADDRESS: 3076 DEDDO CRT

LEGAL DESCRIPTION: LOT 35 DISTRICT LOT: 4050 PLAN: EPP124362

## NOTE:

- 1. THE OCCUPANCY PERMIT WILL BE ISSUED BY THE CITY OF PRINCE GEORGE WHEN THE LOT GRADING AND/OR DRAINAGE SWALES CONFORM TO THE DESIGN AND TO THE SATISFACTION OF THE CITY OF PRINCE GEORGE BUILDING INSPECTOR.
- 2. ELEVATIONS SHOWN ARE FINAL LOT ELEVATIONS.

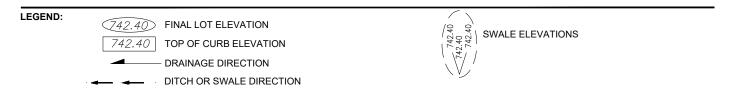

THE INFORMATION CONTAINED HEREIN IS FOR INTERNAL USE ONLY. NOT TO BE RELIED UPON UNLESS CONFIRMED BY SITE INVESTIGATION.

