

City of Prince George HISTORY SHEET

SHEET NUMBER **N^o 1806** Roll Number **011435470**

Legal: LOT'S **13** BLOCK **1427** D.L. **1427** PLAN **15089**

Address: **205 Filled Dr.**

Sanitary Connection: # **50336** SIZE _____ MATERIAL _____ INV. _____ CONNECTED _____

Water Connection # _____ SIZE **20mm** MATERIAL **Cu** METER _____ CONNECTED _____

Storm Connection: # _____ SIZE _____ MATERIAL _____ INV. _____ CONNECTED _____

Cash Receipt No's: WATER _____ SANITARY _____ STORM _____

CURB FROM PROPERTY LINE _____ PAVEMENT WIDTH _____


B.C. HYDRO _____ UNDERGROUND CONNECTION _____

B.C. TELEPHONE _____ UNDERGROUND CONNECTION _____

INLAND GAS _____

Information Sheets: _____

Comments: _____

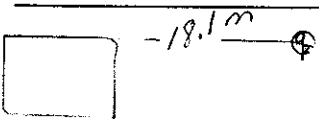

SITE PLAN N.T.S.

