

City of Prince George HISTORY SHEET

871
898
932

SHEET NUMBER

Roll Number

Legal: LOT'S 29-32 BLOCK 6 D.L. 932 PLAN 796

Address: 2119 PINE STREET

Sanitary Connection: # 6586 SIZE 100mm MATERIAL AC. INV. CONNECTED

Water Connection # 6717 SIZE 20mm MATERIAL CU METER CONNECTED

Storm Connection: # SIZE MATERIAL INV. CONNECTED

Cash Receipt No's: WATER SANITARY STORM

CURB FROM PROPERTY LINE PAVEMENT WIDTH

B.C. HYDRO O/H UNDERGROUND CONNECTION



B.C. TELEPHONE O/H UNDERGROUND CONNECTION

INLAND GAS AS SHOWN

Information Sheets:

Comments:

SITE PLAN N.T.S.

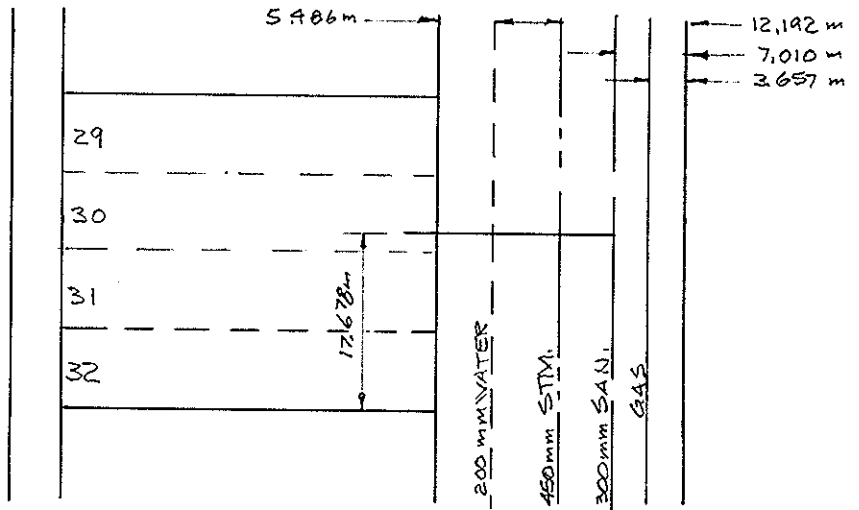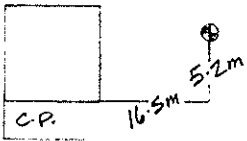

PINE ST.