


## Lot Servicing

1736 4TH AVE

PID: 027179389

**Lot:** PCL A, **Block:** 128, **Plan:** 1268, **DL:** 343 (BB289368)

SERVICE	SIZE	MATERIAL	INSTALLED DATE	LOCATION	DETAILS
WATER	20MM	CU		FR SW COR BLD 5.364M SW 1.524M NW	CONNECTION NUMBER 2631
SANITARY	100MM	UNKNOWN		NO LOCATION	CONNECTION # 2256
SANITARY	UNKNOWN	UNKNOWN		2.743M SE OF NW COR PL	CONNECTION # 2257

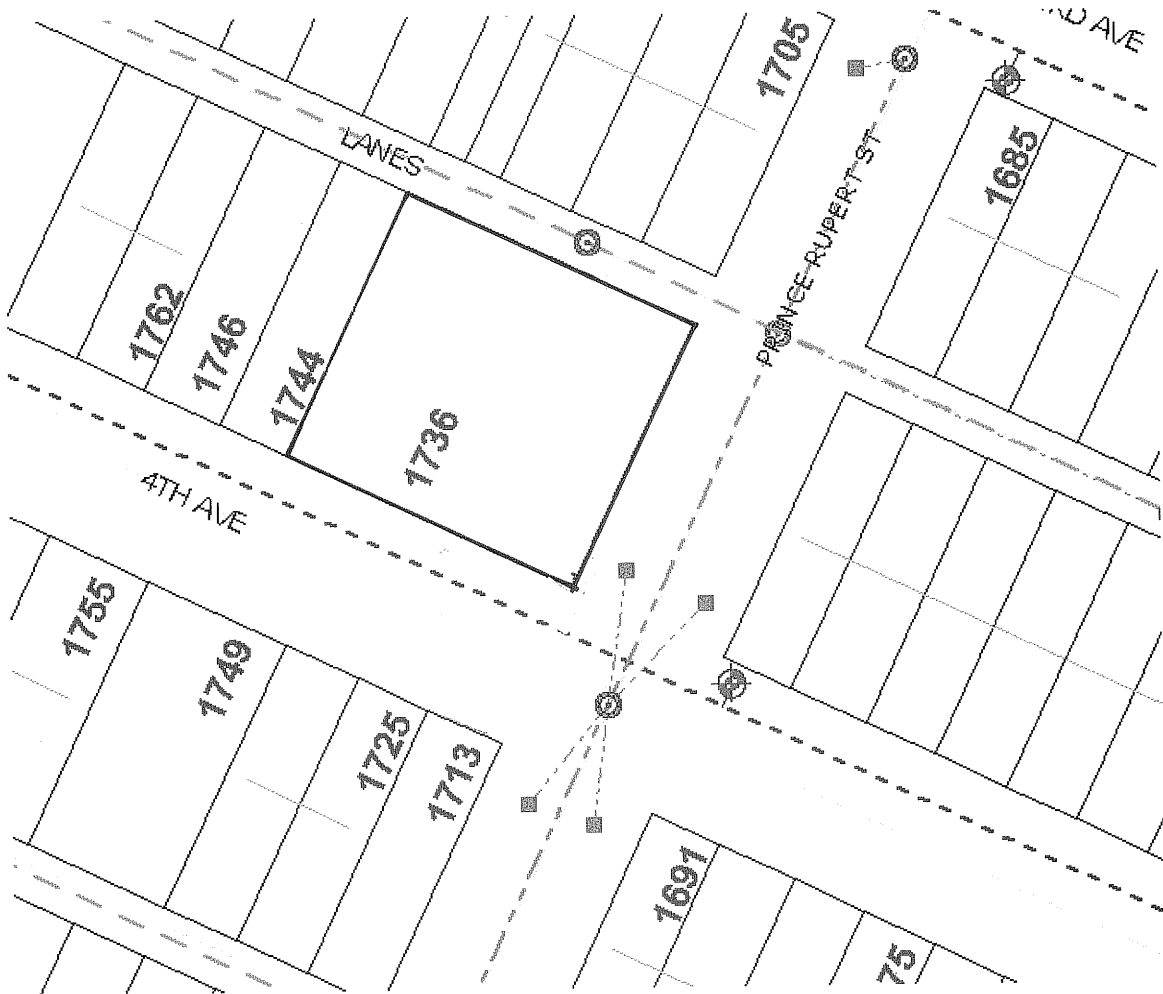

Accuracy not guaranteed unless confirmed by site inspection and/or investigation.  
Connection location between main and property line only.