

City of Prince George HISTORY SHEET

SHEET NUMBER **Nº 1268** Roll Number

Legal: LOT'S **B, B** BLOCK **246-250** D.L. **343** PLAN **1268**

Address: **1593 BIRCH STREET**

Sanitary Connection: # **1259** SIZE **100mm** MATERIAL _____ INV. _____ CONNECTED

Water Connection # **400** SIZE **20mm** MATERIAL **Cu.** METER _____ CONNECTED

Storm Connection: # _____ SIZE _____ MATERIAL _____ INV. _____ CONNECTED

Cash Receipt No's: WATER _____ SANITARY _____ STORM _____

CURB FROM PROPERTY LINE **16'** PAVEMENT WIDTH **34'**


B.C. HYDRO **O.H.** UNDERGROUND CONNECTION _____

B.C. TELEPHONE **O.H.** UNDERGROUND CONNECTION _____

INLAND GAS _____

Information Sheets: _____

Comments: _____

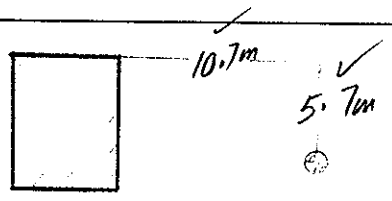

SITE PLAN N.T.S.

