

**City of Prince George
HISTORY SHEET**

003521338

SHEET NUMBER

Roll Number

Legal: LOT'S 1 BLOCK _____ D.L. 913 PLAN 20389

Address: 3013 Clapperton Street

Sanitary Connection: # 8151 SIZE 100mm MATERIAL A.C. INV. _____ CONNECTED

Water Connection # 8151 SIZE 20mm MATERIAL Cu METER _____ CONNECTED

Storm Connection: # _____ SIZE _____ MATERIAL _____ INV. _____ CONNECTED

Cash Receipt No's: WATER _____ SANITARY _____ STORM _____

CURB FROM PROPERTY LINE _____ PAVEMENT WIDTH _____


B.C. HYDRO _____ UNDERGROUND CONNECTION _____

B.C. TELEPHONE _____ UNDERGROUND CONNECTION _____


INLAND GAS _____

Information Sheets: _____

Comments: _____

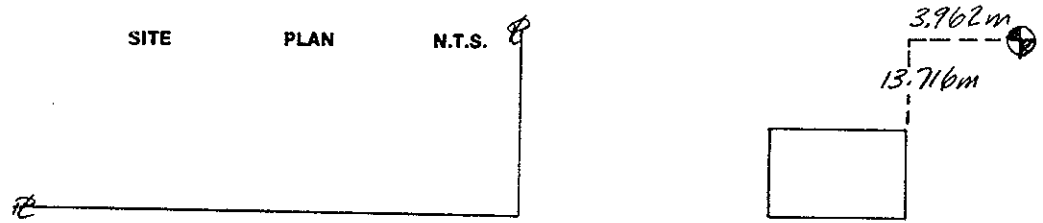

BUCHANAN AVE WEST

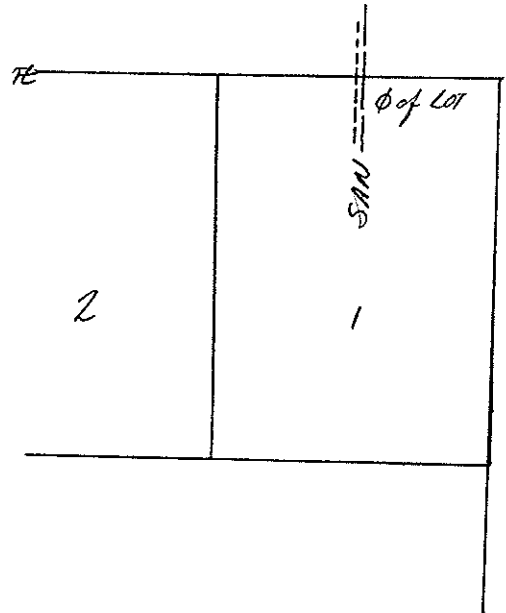

CLAPPERTON ST.

