

City of Prince George
HISTORY SHEET


003625881
559

1974 SFB ASSESSMENT

SHEET NUMBER		Roll Number			
Legal:	LOT'S <u>PARCEL A</u>	BLOCK	D.L. <u>931</u>	PLAN	<u>1810</u>
Address:	<u>2188 NORWOOD ST</u>				
Sanitary Connection:	#	SIZE	MATERIAL	INV.	CONNECTED <u>1974</u>
Water Connection	# <u>12632</u>	SIZE <u>4"</u>	MATERIAL	METER	CONNECTED <u>1974</u>
Storm Connection:	#	SIZE	MATERIAL	INV.	CONNECTED
Cash Receipt No's:	WATER <u>2182</u>	SANITARY	STORM		
CURB FROM PROPERTY LINE	PAVEMENT WIDTH				
B.C. HYDRO	UNDERGROUND CONNECTION				
B.C. TELEPHONE	UNDERGROUND CONNECTION				
INLAND GAS	<u>AS SHOWN</u>				

Information Sheets:


Comments: 2 WATER & SEWER CONNECTIONS MADE IN 1974
CHECK HARVEY PLUMBING FOR LOCATION

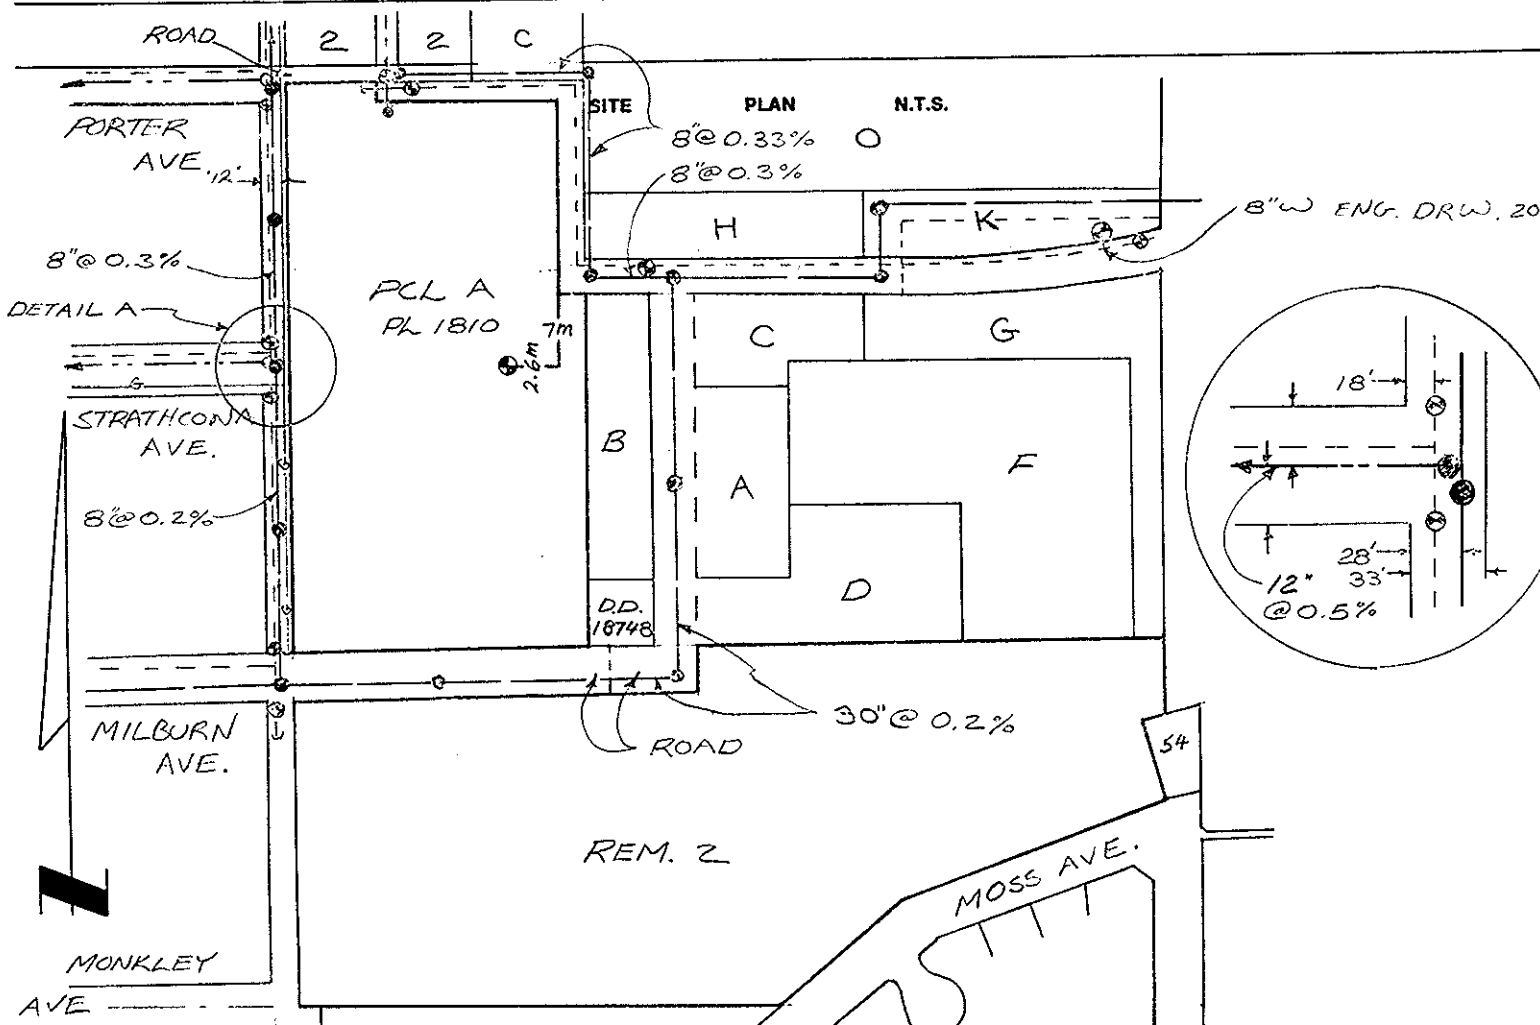

Parcel Report



CITY OF
PRINCE GEORGE

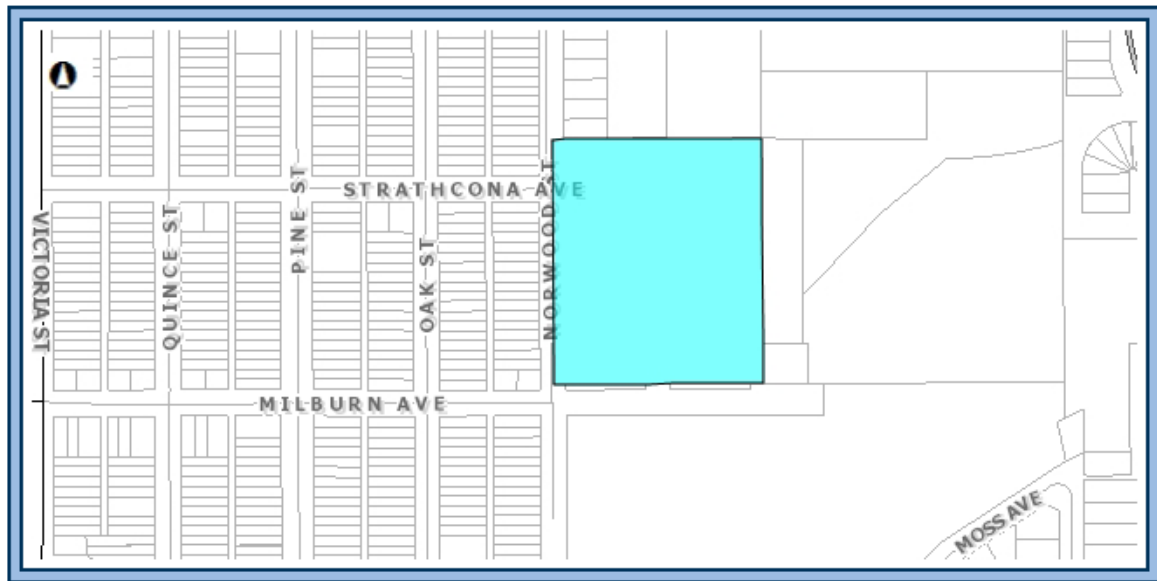

Parcel Details

Data Accuracy not guaranteed.

Legal Information

Civic Address(s):	Suite	Address	Street Name
		2188	NORWOOD ST
	49	2188	NORWOOD ST
	56	2188	NORWOOD ST
	60	2188	NORWOOD ST
	70	2188	NORWOOD ST
	85	2188	NORWOOD ST

Service Connections	Size:	Material:	Installed Date:	Location:
Water	100MM	UNKNOWN	10/24/1979	FR WATER VALVE #338601 4.572M S 5.486M W
		CONNECTION NUMBER	12632	
		CASH RECEIPT NUMBER	2182	
Storm				
Sanitary	UNKNOWN	UNKNOWN		SEE HISTORY SHEET
		CLEANOUT	3.048M S OF PRIVATE MH	