

**City of Prince George
HISTORY SHEET**

003630 919

SHEET NUMBER **5487** Roll Number

Legal: LOT'S **25** BLOCK D.L. **404C** PLAN **26060**

Address: **2656 CARLISLE WAY**

Sanitary Connection: # SIZE **100 mm** MATERIAL **PVC** INV. **735.46** CONNECTED

Water Connection # SIZE **18 mm** MATERIAL **COPPER** METER CONNECTED

Storm Connection: # **NONE** SIZE MATERIAL INV. CONNECTED

Cash Receipt No's: WATER SANITARY STORM

CURB FROM PROPERTY LINE **OPEN DITCH** PAVEMENT WIDTH **8 m**


B.C. HYDRO UNDERGROUND CONNECTION

B.C. TELEPHONE UNDERGROUND CONNECTION

INLAND GAS

Information Sheets:

Comments: **BM: HYD SPINDLE N/W COR NIXON & RIDGEVIEW**
ELEV. 743.712 m

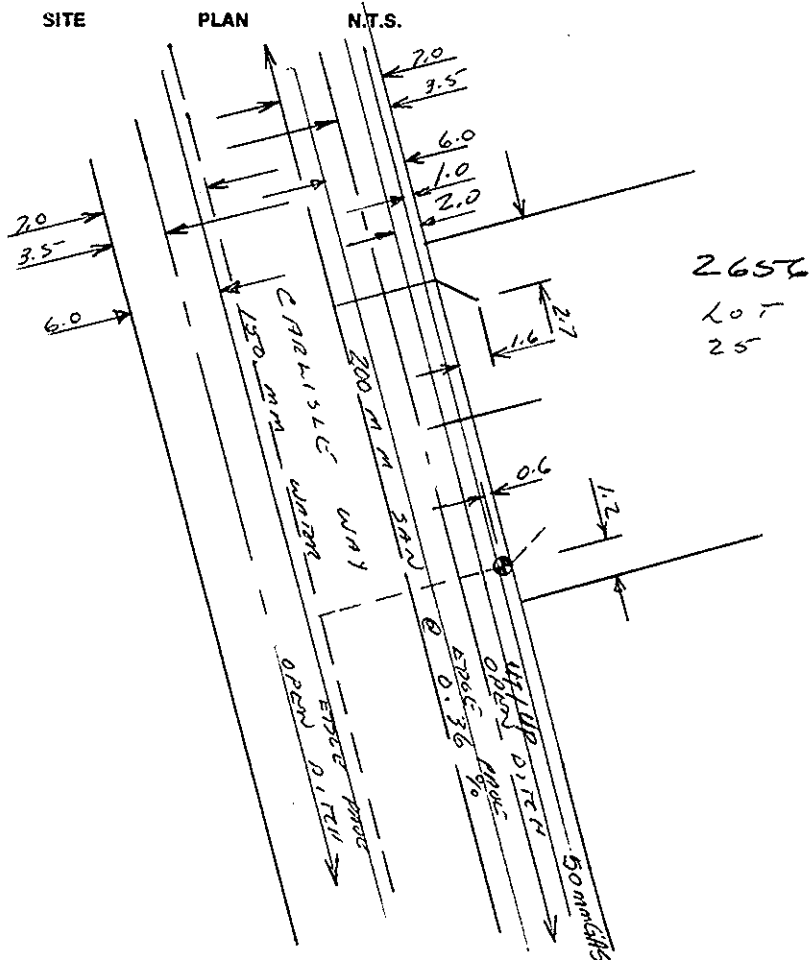

2656
Lot
25