

**City of Prince George
HISTORY SHEET**

003-659-305

SHEET NUMBER

Roll Number

Legal: LOT'S 39. BLOCK _____ D.L. 2610 PLAN 16510

Address: 142 NUGGET Ave

Sanitary Connection: # 5547 SIZE 100mm MATERIAL A.L. INV. 601.424 CONNECTED

Water Connection # 5547 SIZE 200mm MATERIAL Cu METER _____ CONNECTED

Storm Connection: # _____ SIZE _____ MATERIAL _____ INV. _____ CONNECTED

Cash Receipt No's: WATER _____ SANITARY _____ STORM _____

CURB FROM PROPERTY LINE 4.877m PAVEMENT WIDTH 10.363m


B.C. HYDRO U/G UNDERGROUND CONNECTION

B.C. TELEPHONE U/G UNDERGROUND CONNECTION


INLAND GAS 3.048m FROM P.

Information Sheets: WITH THAW WIRE.

Comments: _____

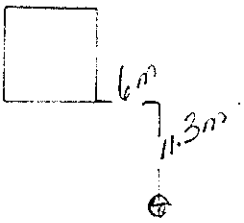

SITE PLAN N.T.S.

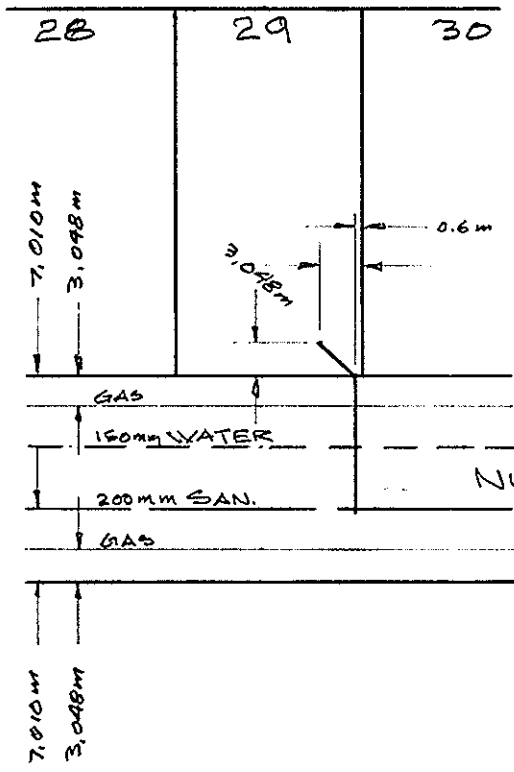

NUGGET AVE.