

**City of Prince George
HISTORY SHEET**

003705277

SHEET NUMBER

Roll Number

Legal: LOT'S 123 BLOCK D.L. 777 PLAN 17401

Address: 2484 BORDEN CRES.

Sanitary Connection: # 6520 SIZE 100mm MATERIAL A.C. INV. CONNECTED

Water Connection # 6520 SIZE 20mm MATERIAL CU. METER CONNECTED

Storm Connection: # SIZE MATERIAL INV. CONNECTED

Cash Receipt No's: WATER SANITARY STORM

CURB FROM PROPERTY LINE 4.877m PAVEMENT WIDTH 10.363m

B.C. HYDRO U/G UNDERGROUND CONNECTION



B.C. TELEPHONE U/G UNDERGROUND CONNECTION

INLAND GAS AS SHOWN

Information Sheets:

Comments: WITH THAW WIRE.

**THE INFORMATION CONTAINED HEREIN IS FOR INTERNAL USE ONLY.
NOT TO BE RELIED UPON UNLESS CONFIRMED BY SITE INSPECTION AND/OR INVESTIGATION**

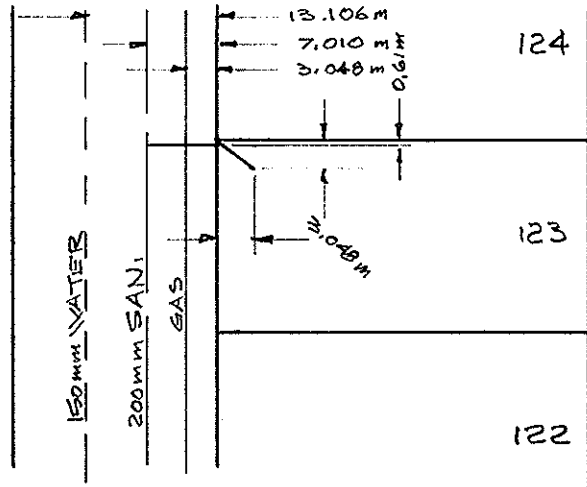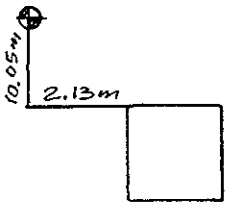

BORDEN CRES.