

City of Prince George HISTORY SHEET

SHEET NUMBER **N^o 2874** Roll Number **20370985C**

Legal: LOT'S **42** BLOCK **7634** D.L. **7634** PLAN **20138**

Address: **2521 Churchill Pl.**

Sanitary Connection: # SIZE **100mm** MATERIAL **P.V.C.** INV. CONNECTED

Water Connection # SIZE **3/4"** MATERIAL **COPPER** METER CONNECTED

Storm Connection: # SIZE MATERIAL INV. CONNECTED

Cash Receipt No's: WATER SANITARY STORM

CURB FROM PROPERTY LINE PAVEMENT WIDTH

B.C. HYDRO **O/H** UNDERGROUND CONNECTION



B.C. TELEPHONE **O/H** UNDERGROUND CONNECTION

INLAND GAS **AS SHOWN**

Information Sheets:

Comments: **WATER SERVICE 3'-0" NORTH OF SOUTH CORNER 80'-0"**
FROM NORTH CORNER OF HOUSE
NID WATER SERVICE

SITE PLAN N.T.S.

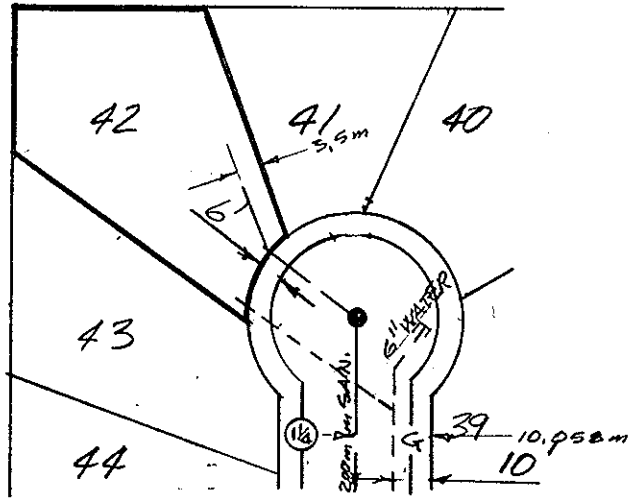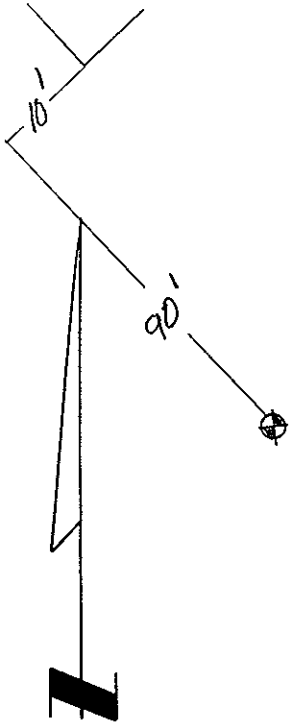

WINSTON PL