

**City of Prince George
HISTORY SHEET**

003723925

SHEET NUMBER

PID #

Legal: LOTS 7 BLOCK 12 D.L. 932 PLAN 796

Address: 2226 OAK STREET

Sanitary Connection: # 7281 SIZE 100 mm MATERIAL A.C INV. 568.585 CONNECTED

Water Connection: # 7517 SIZE 20 mm MATERIAL CU. METER CONNECTED

Storm Connection: # SIZE mm MATERIAL INV. CONNECTED

Cash Receipt No's: WATER SANITARY 521 STORM

CURB FROM PROPERTY LINE 4.877 m PAVEMENT WIDTH 10.363 m

B.C. HYDRO 0/H UNDERGROUND CONNECTION



B.C. TELEPHONE 0/H UNDERGROUND CONNECTION

INLAND GAS 3,962 m FROM WEST SIDE OF OAK ST.

Information Sheets:

Comments: WITH THAW WIER.

**THE INFORMATION CONTAINED HEREIN IS FOR INTERNAL USE ONLY.
NOT TO BE RELIED UPON UNLESS CONFIRMED BY SITE INSPECTION AND/OR INVESTIGATION**

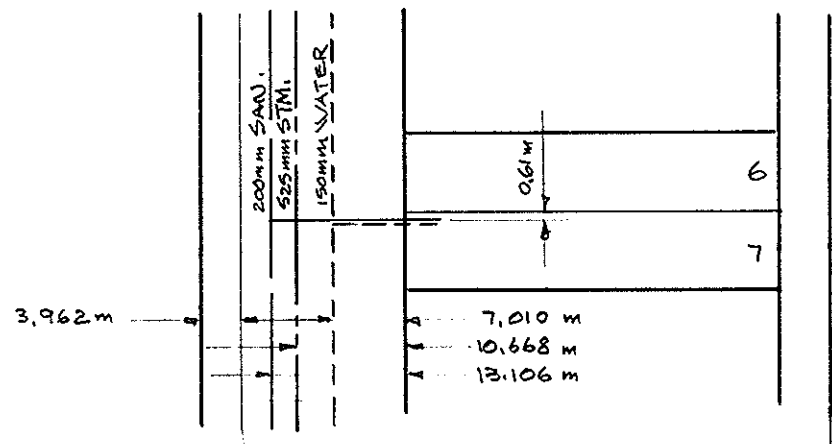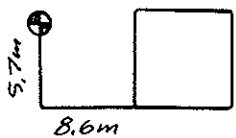

OAK ST.

