



City of Prince George
History Sheet

PID:	003738108
	003738167
	003738213
SD/MU:	
WO:	

Civic Address: 2468 McBride Cres

Legal Description: Lot: 8, 9, B Block: 114 District Lot: 343 Plan: 1268


Service Type	Diameter (mm)	Material	Invert Elev at main (m)	Invert Elev at property line (m)	Invert Elev at service end (m)	Distance into property (m)	Installation Date
Sanitary	100mm	PVC	-	585.62	-	-	January 1957
Water	20mm	Copper	-	-	-	-	January 1957
Storm	N/A	N/A	-	-	-	-	

Service Connection Location				Sanitary (m)	Storm (m)
Distance from downstream San MH	3089	towards upstream San MH	3072	3.94	
Distance from downstream Stm MH	-	towards upstream Stm MH	-		

Power	Size	Communications	Size	Cable	Size	Gas	Size
BC Hydro	-	Telus	-	Shaw	-	FortisBC	-
Overhead Service		Overhead Service		Overhead Service			

Installed by:	Survey Date:	-
Comments:		

NOT TO SCALE The information contained herein is for internal use only.
 Not to be relied on unless confirmed by site inspection and/or investigation.

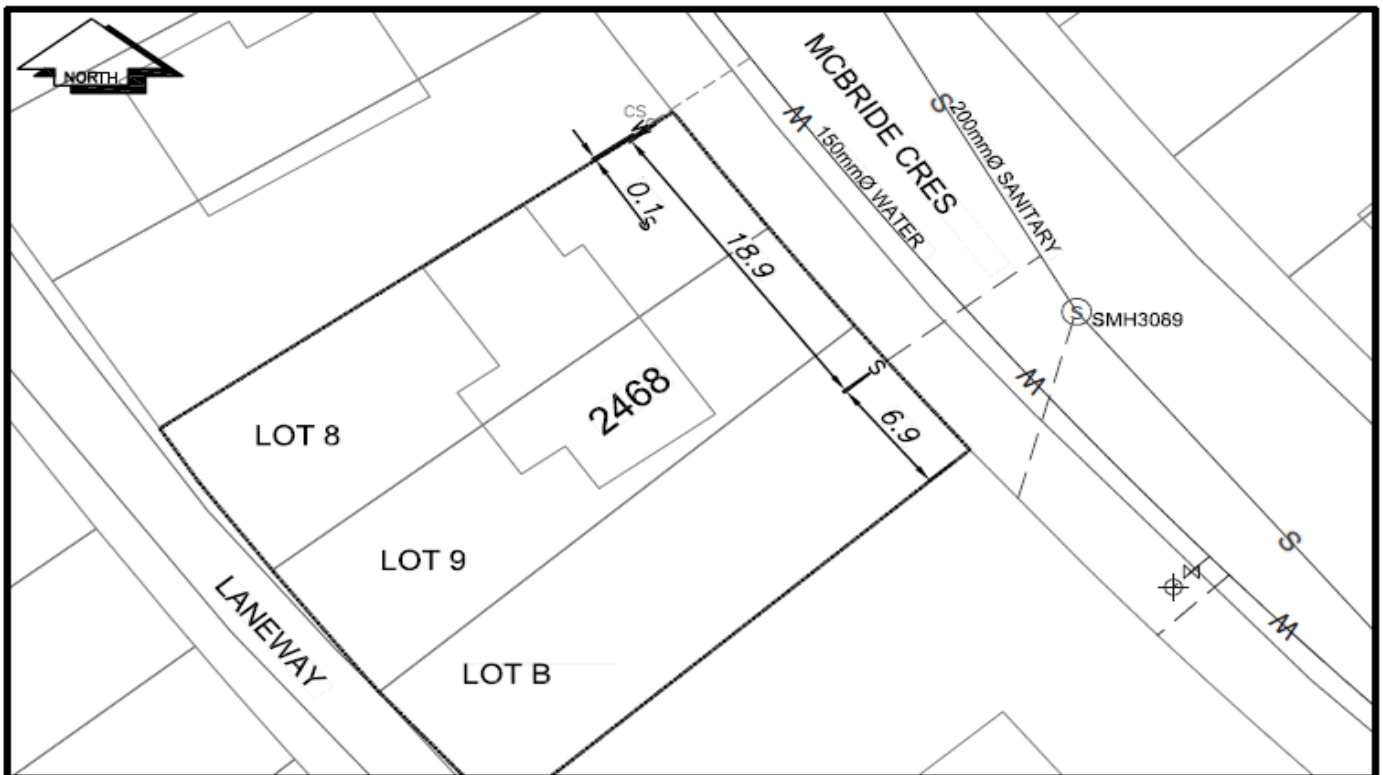

CS	CURB STOP	W	WATER SERVICE	M	STORM SERVICE
CO	CLEAN OUT	S	SANITARY SERVICE	G	GAS
⊗	WATER VALVE	⊗	FIRE HYDRANT	- - -	ENCUMBRANCE

NOT TO SCALE