

**City of Prince George
HISTORY SHEET**

003977511

SHEET NUMBER **7415** Roll Number

Legal: LOT'S 24 BLOCK _____ D.L. 2422 PLAN 21936

Address: 5840 KLUANE RD.

Sanitary Connection: # _____ SIZE _____ MATERIAL _____ INV. _____ CONNECTED _____

Water Connection # _____ SIZE _____ MATERIAL _____ METER _____ CONNECTED _____

Storm Connection: # _____ SIZE _____ MATERIAL _____ INV. _____ CONNECTED _____

Cash Receipt No's: WATER _____ SANITARY _____ STORM _____

CURB FROM PROPERTY LINE _____ PAVEMENT WIDTH _____

B.C. HYDRO _____ UNDERGROUND CONNECTION _____

B.C. TELEPHONE _____ UNDERGROUND CONNECTION _____

INLAND GAS _____


Information Sheets: _____

Comments: _____

SITE PLAN N.T.S.

EDWARD RD.

P/L

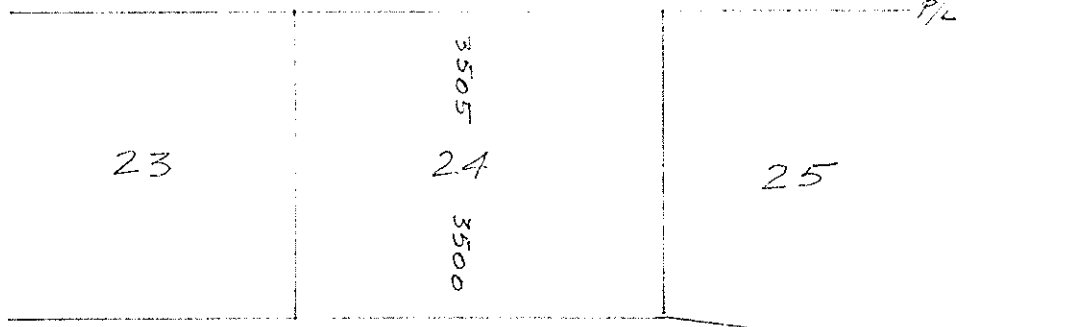

KLUANE RD.

P/L