



City of Prince George
History Sheet

PID:	003826481
MU:	102002
WO:	95725

Civic Address: 1915 3rd Ave

Legal Description: Lot: PCL B Block: 126 District Lot: 343 Plan: 1268 (X9976)


Service Type	Diameter (mm)	Material	Invert Elev at main (m)	Invert Elev at property line (m)	Invert Depth at service end (m)	Distance into property (m)	Installation Date
Sanitary	150mm	AC	-	579.15	1.65	-	December 1956
Water	150mm	PVC	579.03	578.96	-	-	June 2018
Storm	150mm	AC	-	-	-	-	December 1960

Service Connection Location	Sanitary (m)	Storm (m)
150mm sanitconnected to San MH2698	-	
Distance from downstream Stm MH 1079 towards upstream Stm MH 1078		39.41

Power	Size	Communications	Size	Cable	Size	Gas	Size
BC Hydro	-	Telus	-	Shaw	-	FortisBC	-
Overhead Service		Overhead Service		Overhead Service			

Installed by:	City of Prince George forces	Survey Date:	-
Comments:	Water service location confirmed on April 11, 2019		

NOT TO SCALE The information contained herein is for internal use only.
Not to be relied on unless confirmed by site inspection and/or investigation.

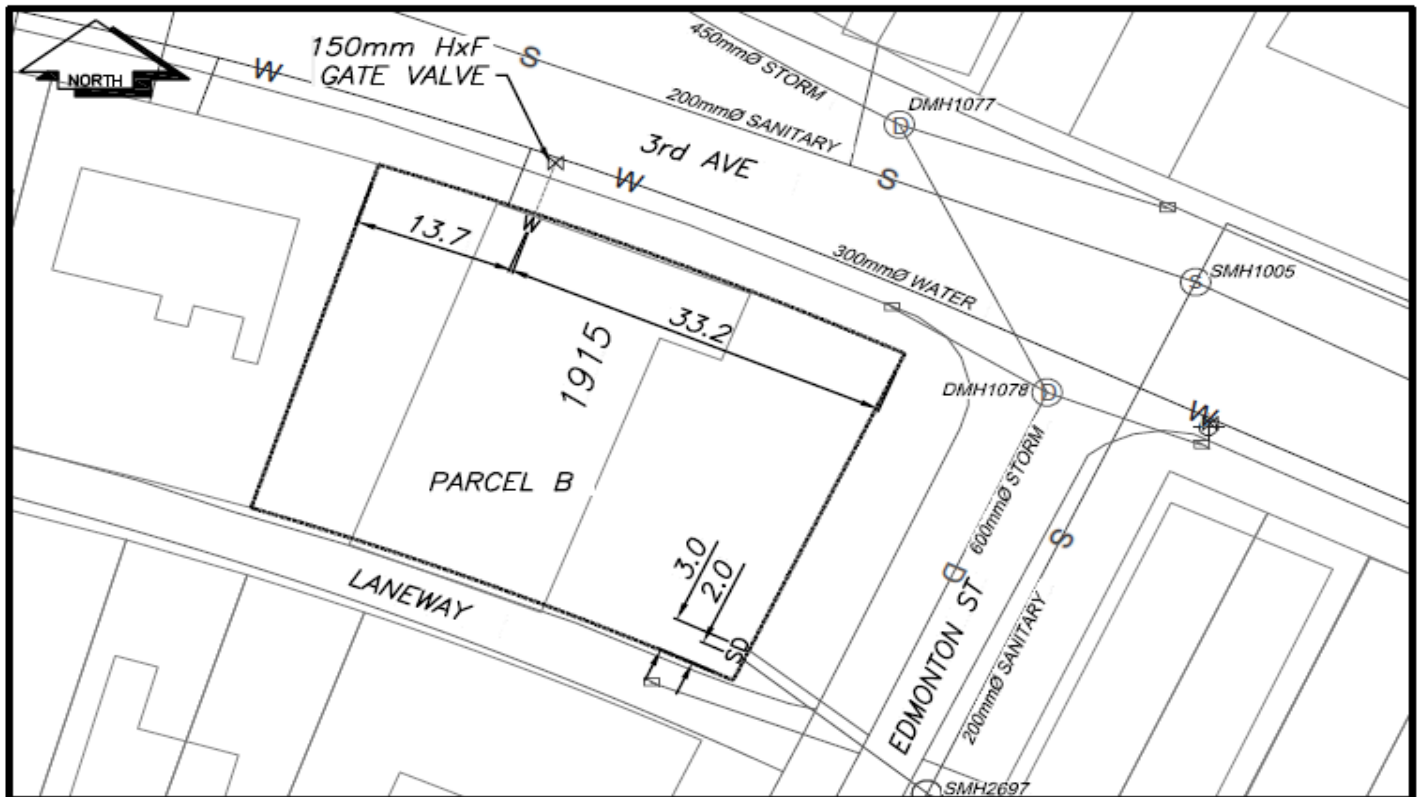

LEGEND:	
CS	CURB STOP
CO	CLEAN OUT
⊗	WATER VALVE
— W	WATER SERVICE
- - - S	SANITARY SERVICE
⊗	FIRE HYDRANT
— G	GAS
- - -	ENCUMBRANCE
⊗	STORM SERVICE

NOT TO SCALE