

City of Prince George HISTORY SHEET

0038660257111
033

SHEET NUMBER _____ Roll Number _____

Legal: LOT'S 22-23 BLOCK 68 D.L. 937 PLAN 752

Address: 380 CENTRAL ST.

Sanitary Connection: # 3024 SIZE 100mm MATERIAL A.C. INV. 596.891 CONNECTED

Water Connection # 3189 SIZE 20mm MATERIAL CU. METER _____ CONNECTED

Storm Connection: # _____ SIZE _____ MATERIAL _____ INV. _____ CONNECTED

Cash Receipt No's: WATER _____ SANITARY _____ STORM _____

CURB FROM PROPERTY LINE 4.877m PAVEMENT WIDTH 9.144m


B.C. HYDRO 0/H UNDERGROUND CONNECTION _____

B.C. TELEPHONE 0/H UNDERGROUND CONNECTION _____


INLAND GAS 3.048m FROM R.

Information Sheets: _____

Comments: WITH THAW WIRE.

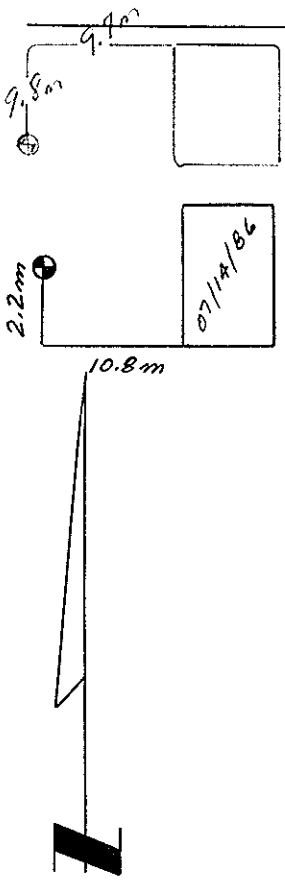

SITE PLAN N.T.S.

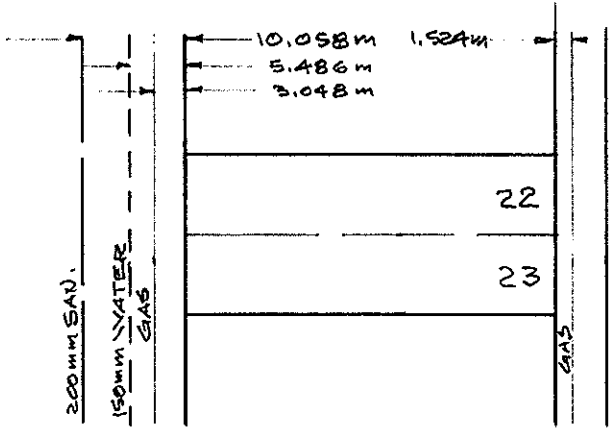

CENTRAL ST.

22
23