

**City of Prince George  
HISTORY SHEET**

0386602511

SHEET NUMBER

Roll Number

033

Legal: LOT'S 22-23 BLOCK 68 D.L. 937 PLAN 752

Address: 380 CENTRAL ST.

Sanitary Connection: # 3024 SIZE 100MM MATERIAL A.C. INV. 596.891 CONNECTED

Water Connection # 3189 SIZE 20MM MATERIAL CU. METER CONNECTED

Storm Connection: # \_\_\_\_\_ SIZE \_\_\_\_\_ MATERIAL \_\_\_\_\_ INV. \_\_\_\_\_ CONNECTED

Cash Receipt No's: WATER \_\_\_\_\_ SANITARY \_\_\_\_\_ STORM \_\_\_\_\_

CURB FROM PROPERTY LINE 4.877M PAVEMENT WIDTH 9.144m


B.C. HYDRO 0/H UNDERGROUND CONNECTION

B.C. TELEPHONE 0/H UNDERGROUND CONNECTION


INLAND GAS 3.048M FROM R.

Information Sheets:

Comments: WITH THAW WIRE.

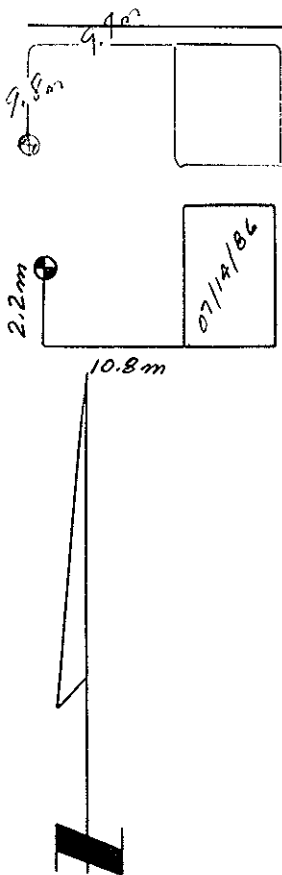

SITE PLAN N.T.S.

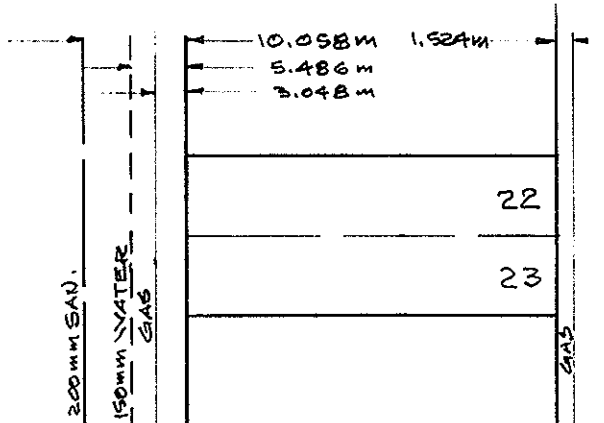

CENTRAL ST.