



City of Prince George
History Sheet

PID:	003874877
SD/MU:	
WO:	

Civic Address: 3333 22nd Ave

Legal Description: Lot: A District Lot: 936 Plan: 19181


Service Type	Diameter (mm)	Material	Invert Elev at main (m)	Invert Elev at property line (m)	Invert Elev at service end (m)	Distance into property (m)	Installation Date
Sanitary	200mm	AC	-	-	-	-	January 1968
Water (east)	200mm	AC	-	-	-	-	January 1966
Water (west)	200mm	AC	-	-	-	-	January 1966
Storm	250mm	AC	-	590.73	-	-	January 1966

Service Connection Location	Sanitary (m)	Storm (m)
200mm Sanitary service connected to San MH 3370	-	
250mm Storm service connected to Stm MH 2176		

Power	Size	Communications	Size	Cable	Size	Gas	Size
BC Hydro	-	Telus	-	Shaw	-	FortisBC	-
Underground Service		Underground Service		Underground Service			

Installed by:	Survey Date:	-
Comments:		

NOT TO SCALE The information contained herein is for internal use only.
Not to be relied on unless confirmed by site inspection and/or investigation.

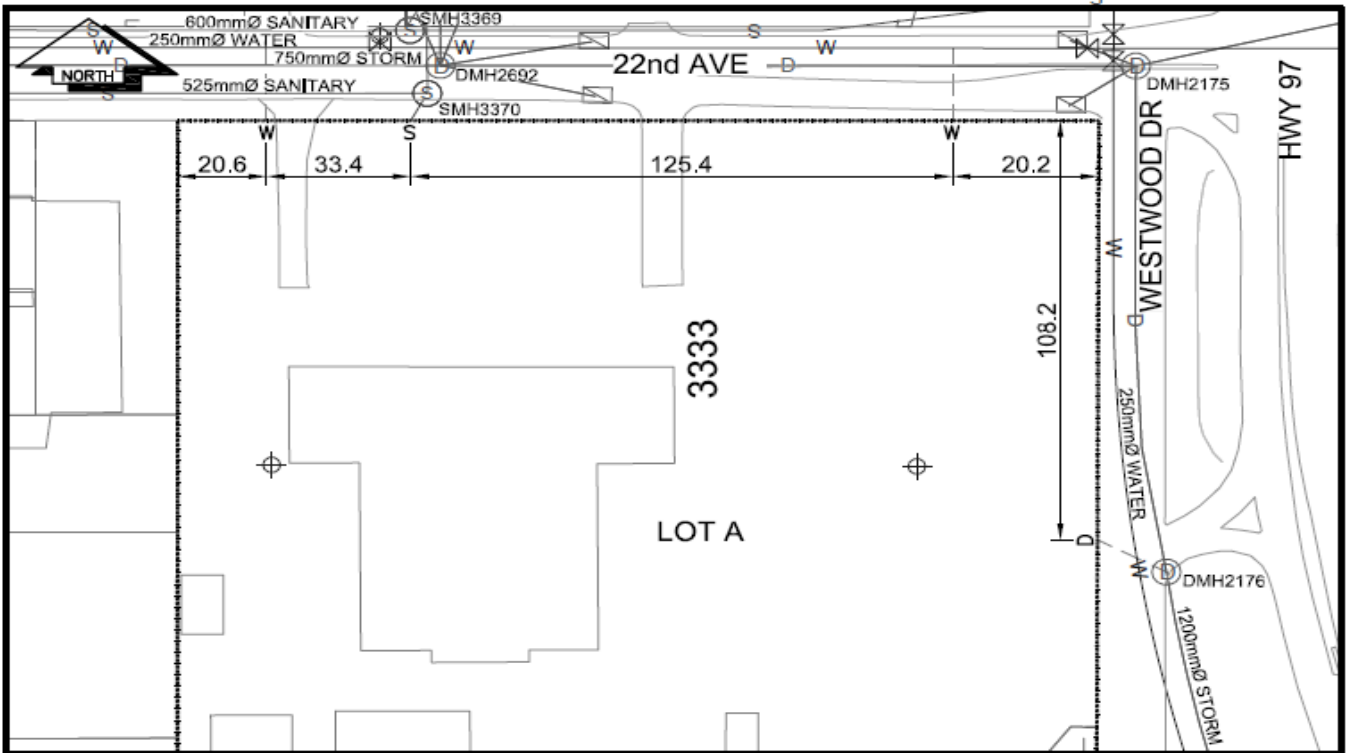

LEGEND:

CS	CURB STOP	---	W	WATER SERVICE	---	D	STORM SERVICE
CO	CLEAN OUT	---	S	SANITARY SERVICE	---	G	GAS

NOT TO SCALE