

City of Prince George HISTORY SHEET

170
376

SHEET NUMBER **N^o 1494** Roll Number

Legal: LOT'S **17, 18, 19** BLOCK **90** D.L. **937** PLAN **752**

Address: **242 DOUGLAS STREET**

Sanitary Connection: # **1830** SIZE MATERIAL INV. CONNECTED

Water Connection # **1262** SIZE **3/4"** MATERIAL **COPPER** METER CONNECTED

Storm Connection: # SIZE MATERIAL INV. CONNECTED

Cash Receipt No's: WATER SANITARY STORM

CURB FROM PROPERTY LINE PAVEMENT WIDTH


B.C. HYDRO UNDERGROUND CONNECTION

B.C. TELEPHONE UNDERGROUND CONNECTION

INLAND GAS

Information Sheets:

Comments:

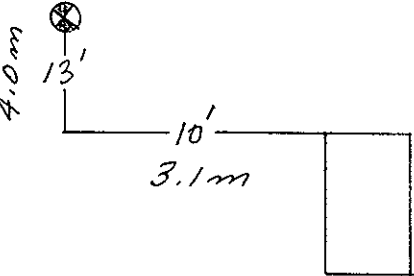

SITE PLAN N.T.S.

DOUGLAS

