

**City of Prince George  
HISTORY SHEET**

003920921  
003961168

SHEET NUMBER **No 1870** Roll Number

Legal: LOT'S **3,4** BLOCK **317** D.L. **343** PLAN **1268**

Address: **1829 REDWOOD STREET**

Sanitary Connection: # **4443** SIZE **4"** MATERIAL **AC.S.** INV. **CONNECTED**

Water Connection # **4211** SIZE **3/4"** MATERIAL **COPPER** METER **CONNECTED**

Storm Connection: #  SIZE  MATERIAL  INV. **CONNECTED**

Cash Receipt No's: WATER  SANITARY  STORM

CURB FROM PROPERTY LINE  PAVEMENT WIDTH

B.C. HYDRO  UNDERGROUND CONNECTION



B.C. TELEPHONE  UNDERGROUND CONNECTION

INLAND GAS

Information Sheets:

Comments:

SITE                      PLAN                      N.T.S.

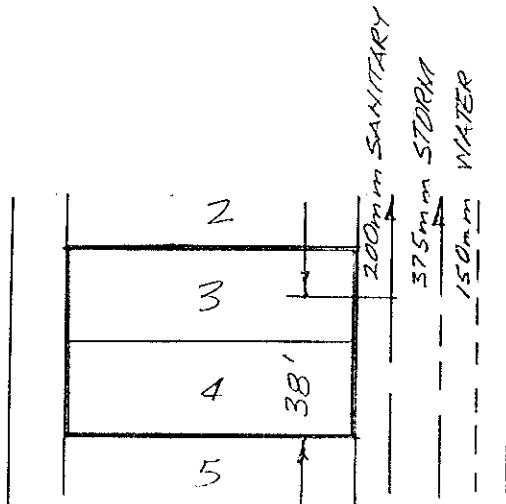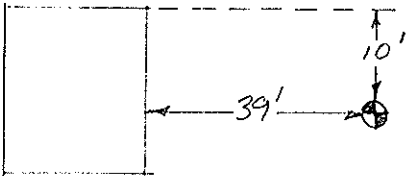

**REDWOOD**